

33-36-44 90-11-12

MISSISSIPPI DEPARTMENT OF ENVIRONMENTAL QUALITY

Office of Land and Water Resources

COUNTY WELL LOCATED
 LeFlore

WELL NUMBER
H-134

CODED

PERMIT NUMBER

NAME OF DRILLING FIRM
 Irrigation Equipment Inc.

Indianola, MS

DATE WELL COMPLETED
 4-2-04

P. O. Box 10631

Jackson, MS 39289-0631

WATER WELL DRILLERS LOG

NAME & MAILING ADDRESS OF LANDOWNER
 Greg Carr Farms
 Box 252
 Marks, MS 38646

PUMP DATA

PUMP TYPE (Circle One):
 Submersible, Turbine, Jet, Flowing Well,
 Other (Describe)

POWER TYPE (Circle One):
 Electric, Tractor, Diesel, Gasoline, Butane,
 Other (Describe) _____ H/P _____

Latitude:
 Longitude:

WELL LOCATION: SEC TOWNSHIP RANGE
 SW/NW 10 20N N 1E E
 S W W

DESCRIPTION OF FORMATIONS ENCOUNTERED	FROM	TO
Clay	0	15
Fine Sand	16	35
Med. Sand/gravel	36	55
Coarse Sand/gravel	56	114

DISTANCE DIRECTION NEAREST TOWN
 _____ Miles _____ of _____

OTHER LANDMARK

WELL PURPOSE: Home, Irrigation, Municipal, Industrial, Fish Pond, etc.
 Replacement Irrigation Pivot

WELL DATA

Well Depth 114	Casing Diameter (In.) 16	Casing Length (Ft.) 74
-------------------	-----------------------------	---------------------------

Type of Casing pvc	Hole Depth 114	Depth to Static Water Level
-----------------------	-------------------	-----------------------------

TYPE OF COMPLETION: (Circle One or More):
 Gravel Packed, Underreamed, Telescoped,
 Natural Development, Open Hole, Other
 (Describe)

WELL GROUTED TO A DEPTH OF 10 FEET
 Type Grout (circle one): Cement, Bentonite, or Mix

SCREEN DATA

Diameter - Inches 16	Length - Feet 40	Slot Size - Inches 050
-------------------------	---------------------	---------------------------

Screen Type pvc	Depth to Bottom - Feet 114
--------------------	-------------------------------

RECEIVED

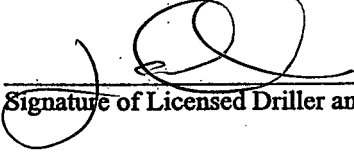
APR 19 2004

BY: OLWR

Top of Lap Pipe or Reduction in Casing

FEET IF TELESCOPED OR MORE THAN ONE SCREEN: USE BACK PAGE

I certify that the well was drilled, constructed and completed in accordance with all applicable Requirements of the Mississippi Department of Environmental Quality and/or the Mississippi Department of Health regulations and state laws.


 Signature of Licensed Driller and License No.

0439

4-15-04

Date

Additional Information Required On Back

If well telescopes please sketch and show depths.

GROUND LEVEL

X			

SECTION 10

Please indicate well location X.

Pump Capacity (GPM)	No. of Stages	Setting Depth
2000	3	70 FT.

PUMP TEST

Well yielded _____ GPM with
 a drawdown of _____ ft.
 after _____ hours of pumping

LOG DATA

TYPE OF LOG RUN (Circle One): No Log Run,
 Electric, Gamma Ray, Density, Sonic, Neutron,
 Other (Describe) _____

Name of Organization Running Log _____

GEOLOGIC DATA (Office Use Only)

Surface Elev.	Geologic Unit	Unit Thickness	Depth to Top
Subs. SWL	Date	Analysis	Aquifer Test

Driller's Remarks

Pump installed by Peacock
 Pump & Repair, Cleveland.

If more than one screen,
 show location of each on sketch.