

MISSISSIPPI DEPARTMENT OF ENVIRONMENTAL QUALITY

Office of Land and Water Resources

COUNTY WELL LOCATED  
**Leflore**  
 WELL NUMBER CODED  
**H-135**  
 DATE WELL COMPLETED  
**4-2-04**

PERMIT NUMBER  
 NAME OF DRILLING FIRM  
**Irrigation Equipment Inc.**  
**Indianola, MS**

P. O. Box 10631  
 Jackson, MS 39289-0631  
**WATER WELL DRILLERS LOG**

NAME & MAILING ADDRESS OF LANDOWNER  
**Greg Carr Farms**  
**Box 252**  
**Marks, MS 38646**

Latitude:  
 Longitude:

WELL LOCATION: SEC TOWNSHIP RANGE  
**NW/NW 2 20N N 1E E W**  
 DISTANCE DIRECTION NEAREST TOWN  
 \_\_\_\_\_ Miles **SE** of **Money**

OTHER LANDMARK  
 WELL PURPOSE: Home, Irrigation, Municipal, Industrial, Fish Pond, etc.  
**Replacement Irrigation Pivot**

**WELL DATA**

Well Depth <b>114</b>	Casing Diameter (In.) <b>16</b>	Casing Length (Ft.) <b>74</b>
Type of Casing <b>pvc</b>	Hole Depth <b>114</b>	Depth to Static Water Level

TYPE OF COMPLETION: (Circle One or More):  
 Gravel Packed,  Underreamed,  Telescoped,  
 Natural Development,  Open Hole,  Other  
 (Describe)

WELL GROUTED TO A DEPTH OF **10** FEET  
 Type Grout (circle one): Cement,  Bentonite or Mix

**SCREEN DATA**

Diameter - Inches <b>16</b>	Length - Feet <b>40</b>	Slot Size - Inches <b>.050</b>
Screen Type <b>pvc</b>	Depth to Bottom - Feet <b>114</b>	

**PUMP DATA**

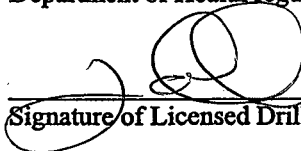
PUMP TYPE (Circle One):  
 Submersible,  Turbine, Jet, Flowing Well,  
 Other (Describe) \_\_\_\_\_  
 POWER TYPE (Circle One):  
 Electric, Tractor, Diesel, Gasoline, Butane,  
 Other (Describe) \_\_\_\_\_ H/P \_\_\_\_\_

DESCRIPTION OF FORMATIONS ENCOUNTERED	FROM	TO
Clay	0	25
Fine sand	26	35
Med. sand/gravel	36	65
Coarse Sand/gravel	66	85
Rock	86	95
Med. Sand/gravel	96	114

**RECEIVED**  
**APR 13 2004**  
**BY: OLWR**

Top of Lap Pipe or Reduction in Casing  
 FEET IF TELESCOPED OR MORE THAN ONE SCREEN: USE BACK PAGE

I certify that the well was drilled, constructed and completed in accordance with all applicable Requirements of the Mississippi Department of Environmental Quality and/or the Mississippi Department of Health regulations and state laws.

 0439  
 Signature of Licensed Driller and License No.

4-15-04  
 Date

If well telescopes please sketch and show depths.

GROUND LEVEL

X			

SECTION 2

Please indicate well location X.

Pump Capacity (GPM)	No. of Stages	Setting Depth
1400	4	70 FT.

PUMP TEST

Well yielded \_\_\_\_\_ GPM with  
 a drawdown of \_\_\_\_\_ ft.  
 after \_\_\_\_\_ hours of pumping

LOG DATA

TYPE OF LOG RUN (Circle One): No Log Run, Electric, Gamma Ray, Density, Sonic, Neutron, Other (Describe) \_\_\_\_\_

Name of Organization Running Log \_\_\_\_\_

GEOLOGIC DATA (Office Use Only)

Surface Elev.	Geologic Unit	Unit Thickness	Depth to Top
Subs. SWL	Date	Analysis	Aquifer Test

Driller's Remarks

Pump installed by Peacock  
 Pump & Repair, Cleveland.

If more than one screen,  
 show location of each on sketch.