County:Leflore	State Well Report Part 1	For Office Use Only:
	Mississippi Department of Environmental Quality	
Permit #: <u>GW40369</u> Irrigation Equipment	Office of Land and Water Resources P.O. Box 10631	Well #:
Driller:	Jackson, MS 39289-0631	L. S. Elevation:
Date drilling completed: $10 - 4 - 05$	(601)961-5210	E-log #:
	(601)354-6938 (fax)	E-log #:
30 days of completion of drilling		
Well Owner Inform Yalo Bush Far		ell Location
Owner Name_ C/O David Cor	Latitude: 33 • 37 .52	N <sup>-</sup> Longitude: 90 07, 96W
Mailing Address: 7600 County	7 Road 350 Method of Lat/Long (circle	$\frac{N_{7}}{3}$ Longitude: 90 07, 96 3 one): Conventional Survey,
	1	ld GPS, Survey-grade GPS
Greenwood,	MS 38930	Twn 20N Rng 2E
	te Zin Code Distance Direction	Nearest Town
Telephone No. ()		of Greenwood
······		
	Well Data	
Purpose of Well (circle one) Home Ind	dustrial Public Supply (rrigation) Fish Culture	Other:
Date well drilling started:10-0	4-05 Date well drilling completed:1	0-4-05
If flowing, method of flow regulation: Va	lve Other (describe)	
Static Water Level: <u>13'</u> feet a	bove or below (circle one) land surface Date measured	±10
Method of Measurement (circle one) (s	teel tape electric tape air line other:	
Hole depth: <u>116</u> Well de	pth: <u>116'</u> Well grouted to a depth of	feet
Type of grout (circle one): Cement	Bentonite Mix	
Casing length: 76 feet Casi	ing diameter: <u>16</u> inches Type of casing:	PVC Sch.40
Screen length: <u>40</u> feet Screen	een diameter: <u>16</u> inches Type of screen:	PVC Sch.40
Screen slot size: <u>.050</u> inches	Setting depth: From 77feet to	<u>116</u> <b>feet</b>
Type of completion (circle all applicable):	Gravel packed Underreamed Telescoped Ope	en hole Natural Development
	Other (describe):	
Top of lap pipe or reduction in casing:	feet. If telescoped or more than one s	creen, describe on back of page
Logs run (circle all applicable): No log r	m Electric Gamma Ray Density Sonic Neutron	Other:
Name of organization running log(s):		
	ructed, and completed in accordance with all applicab	-
	and/or the Mississippi Department of Health regulation	ons and state laws.
Irrigation Equipm		mall
Patrick M. Chism	0695 Jan	1 Chin


RECEIVED OCT 2 0 2005 BY: OLWR If well telescopes please sketch below and show depths.

## Ground Level

Description of Formations Encountered	From	To
Clay	0	18
Fine Sand	19	25
Fine Sand/gravel Med. Sand/gravel	26	37
Med. Sand/gravel	38	112
Clay	113	116
	L	
	ļ	
	<u> </u>	
	ļ	
	ļ	
		<u> </u>
		<u> </u>

H-

If more than one screen, show location of each on sketch

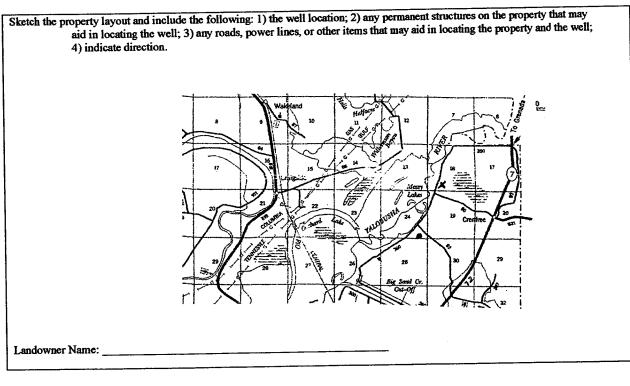

Signature of Water Well Contractor

County:Leflore Permit #: Irrigation Equipment Driller: Date completed:10-5-05	Punap Installer Mississippi Departm Office of Land P.O Jackson, (60	Part 2 r's Completion Report ent of Environmental Quality d and Water Resources . Box 10631 MS 39289-0631 1)961-5210 354-6938 (fax)	For Office Use Only: Aquifer: 157 Well #: <u>H-</u> Elevation:
This report should be prepared by the installation of pump. Well Owner, Informati	ion		ent within 30 days of the
Yalo Bush Farm Owner Name: c/o David Conv		Latitude:	_Longitude:
Mailing Address: 7600 County	<u>Road 35</u> 0	Method of Lat/Long (circle or	ne): Conventional Survey,
		USGS quad, Hand	l-held GPS, Survey-grade G
Greenwood, M	<u>45 3893</u> 0		<sup>3</sup> Twn <sup>20N</sup> Rng <sup>2E</sup>
City State	Zip Code	Distance Direction	Nearest Town
Telephone No. ()		6 <u>Miles NE</u> c	f Greenwood
Pump Type Circle one			wer Type ircle one
Air Lift Jet	Submersible		ne Engine Natural (
Bucket Piston	Turbine	Electric Motor Hand	Tractor P
Centrifugal Rotary	Flowing Well	Windmill Other	(specify):
Other (specify):	· · ·	Horse Power Rating of Motor	- 40
			•
Date Pump Installed: 10-5-05		Setting Depth:	
Date Pump Installed: <u>10-5-05</u>	Gallons Per Minute		foet
Date Pump Installed: $10-5-05$		Setting Depth: Number of Stages: Method of Met	<u>50</u> foot 3 asuring Water Level
Date Pump Installed:10-5-05 Rated Pump Capacity:	Gallons Per Minute	Setting Depth: Number of Stages: Method of Method	<u>50</u> feet 3 casuring Water Level bircle one
Date Pump Installed: <u>10-5-05</u> Rated Pump Capacity:	Gallons Per Minute	Setting Depth: Number of Stages: Method of Method Air Line Electric Mea	5.0foet 3 casuring Water Level vircle one suring Line Steel Tap
Date Pump Installed: 10-5-05 Rated Pump Capacity: Pump Test Data Date Well Tested:	Gallons Per Minute	Setting Depth: Number of Stages: Method of Method	5.0foet 3 casuring Water Level vircle one suring Line Steel Tap
Date Pump Installed:       10-5-05         Rated Pump Capacity:       0         Pump Test Data         Date Well Tested:         Static Water Level (A):       Feet H         Pumping Water Level (B):       Feet B         Drawdown [(B) - (A)]:       Feet H	Gallons Per Minute Gallons Per Minute Below Land Surface Below Land Surface Below Land Surface	Setting Depth: Number of Stages: Method of Method Air Line Electric Mea	<u>50</u> feet <u>3</u> casuring Water Level bircle one ssuring Line Steel Tap
Date Pump Installed:       10-5-05         Rated Pump Capacity:       0         Pump Test Data         Date Well Tested:         Static Water Level (A):       Feet H         Pumping Water Level (B):       Feet B	Gallons Per Minute Gallons Per Minute Below Land Surface Below Land Surface Below Land Surface	Setting Depth: Number of Stages: Method of Method Air Line Electric Mea Other (specify):	feet feet 

•

RECEIVED