

**MISSISSIPPI DEPARTMENT OF NATURAL RESOURCES**  
**Bureau of Land and Water Resources**  
 Southport Mall  
 P.O. Box 10631  
 Jackson, Mississippi 39209  
**WATER WELL DRILLERS LOG**

*Leflore*  
G-39  
 H169  
 GW12264

GW12264

**CODED**

5-13 1982 *Dyer Well* *Leflore*  
 date well completed firm name county well located

LANDOWNER: *Ronald Conway*

description of formations encountered	from	to
<i>Clay</i>	0	18
<i>fine sand</i>	18	30
<i>Sand</i>	30	75
<i>Sand &amp; gravel</i>	75	113

(mailing address)

WELL LOCATION:  
 sec. 12 T 20 N R 1E  
4 miles se of Money  
 (distance) (direction) (nearest town)

WELL PURPOSE:  
 (home, irrigation, municipal, industrial)

WELL COMPLETION DATA:

- (1) diameter (inches) 16
- (2) total depth (feet) 113
- (3) static water level (feet) 15 below above top of ground.
- (4) casing Steel 80  
 (material) (depth)  
16  
 (size) If telescope see back.
- (5) screen 40 73  
 (length) (depth to top)  
16 Field Steel  
 (size) (material)
- (6) gear 60 3000  
 pump (HP) (yield gpm)  
diesel  
 (type power)
- (7) electric log No  
 (yes or no)  
 (organization running log)
- (8) how well bottom plugged late

DRILLERS REMARKS:


DEPT. OF NATURAL RESOURCES  
 BUREAU OF LAND & WATER RESOURCES

SEP 30 1982

**RECEIVED**

If well telescopes please sketch and show depths.

GROUND LEVEL

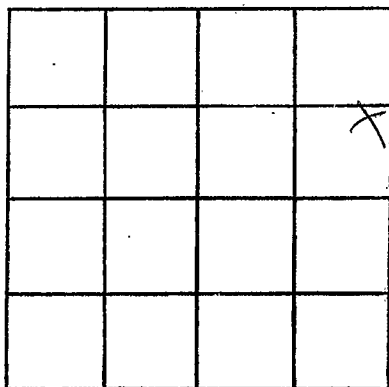

SECTION 12

Please indicate well location X.

ADDITIONAL INFORMATION

If more than one screen,  
show locations of each on sketch.