 ▲ 	
County: <u>LEFIONE</u> Permit #: <u>GW-47137</u> Driller: <u>bel_Jumper</u> Date drilling completed: <u>S-IS-13</u> State Law requires that this report be prepared by the <u>Department at the above address within 30 days of con</u> <u>Well Owner Information</u> (Landowner if borehole is not for a water well) Owner Name: <u>ASA</u> <u>Bennet</u>	WELL REPORT Part 1 Driller's Log tment of Environmental Quality and and Water Resources P.O. Box 2309 son, MS 39225-2309 (601)961-5210 Son, MS 39225-2309 (601)961-5210 1)360-0535 (fax) e license holder responsible for the work and filed with the sompletion of drilling of the well or borehole. Well or Borehole Location Latitude: 33-37-34_ Longitude: 90-11-54_ Method of Lat/Long (check one): Conventional Survey,
Mailing Address: <u>COS</u> Kobert E Lee	USGS quad, Hand-held GPS, Survey-grade GPS
City State Zip Code	<u>SW</u> <u>WE</u> <u>4</u> , sec <u>O4</u> <u>T</u> <u>20</u> <u>N</u> <u>R</u> <u>OIE</u> <u><u></u><u></u><u></u><u></u><u></u><u></u><u></u><u></u><u></u><u></u><u></u><u></u><u></u><u></u><u></u><u></u><u></u><u></u></u>
Location of the source of any surface water used for drillin Method of dosing and volume of Chlorine used in drilling an Logs run (<i>circle all applicable</i>): No log run Electric Gamm Name of organization running log(s):	nd development:
Purpose of borehole (circle one) (Water Well Geotechnic	cal/Geological Investigation Ground Source Heat Pump
	describe)
Purpose of Well (<i>circle all applicable</i>): Home Industrial Other (<i>describe</i>): If a flowing well, method of flow regulation: Valve Static Water Level:7 feet [above or below (<i>circle one</i>) Method of measurement (<i>circle one</i>) Steel tape Electric ta Well depth:9 Well grouted to a depth of: fee Casing length:9 feet Casing diameter: Screen length: feet Screen diameter: Screen slot size: inches Setting depth:	Public Supply Irrigation Fish Culture Other (describe) Other (describe) ape Air line Other (describe): ape Air line Other (describe): eet Type of grout (circle one): Neat Cement Bentonite Mix //O inches Type of casing: $\rho V C$ //O inches Type of screen: $\rho V C$ From O O feet to
Type of completion (<i>circle all applicable</i>): Gravel packed	Underreamed Open hole Natural Development EIVE
Other (describe):feet	

~


If telescoped or more than one screen, describe on next page

BY- 01473

The sketch below only required for water wells	Description of formations encountered wells and burcholes, anless specifically	must be provided for exempted by regula	or all <u>stious</u>
If well telescopes, show depths on sketch. Ground Level	Description of Formations Encountered		o (depth)
	Description of Formations Encountered	From (depth) To Ground Level	(depth) 10 40 (eO FO 100 100 109

If more than one screen, show location of each on sketch

.

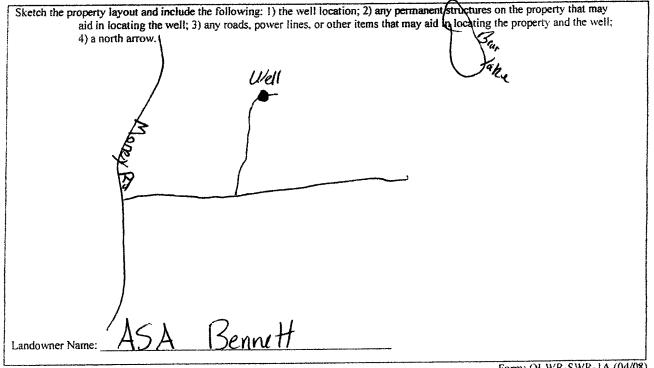

Form: OLWR-SWR-1A (04/08)

I certify that the well/borehole was drilled, constructed, and completed in accordance with all applicable requirements of the Mississippi Department of Environmental Quality and the Mississippi Department of Health regulations, if applicable, and state

laws 5311 5-15-13 Jumper UDE

Print Name of Responsible Licensee and License No.

Date

Signature of Licensee 'JUN 1 3 2013

BY: OLWA

SEIVED

STATE	WELL REPORT			
County: LEFLOIZE	Part 2			
	ller's Completion Report	For Office Use Only:		
Mississippi Depa	rtment of Environmental Quality	Well #:		
Date completed: <u>5-15-13</u>	Land and Water Resources P.O. Box 2309			
Jac	kson, MS 39225-2309	Aquifer:		
Copy information from block on Part 1	(601)961-5210 501) 360-0535 (fax)			
This part of the report must be completed by a licensed we of the report must be attached and both parts filed with the	tter well contractor or a licensed put e Department at the above address v	mp installer. A copy of Part 1 within 30 days of well completion.		
Well Owner Information				
Owner Name: BARE BONES F.9Rms	Latitude: <u>33° 37· 34 "</u> Lor	ngitude: <u>90°//·54′·</u>		
Mailing Address: 605 ROBLET E LEE DR	Method of Lat/Long (check one): Conventional Survey,		
•	USGS quad, Hand-held G			
CRECILING MS 38931		OY T_ZON R_ÓIE		
<u>GREENWOOD MS</u> 38930 City State Zip Code				
Telephone No. (do2) 453-0504	(Distance) (Direction)	f <u>Moxy</u> (Nearest Town)		
Pump	Type (circle one)			
Submersible Turbine Air Lift Centrifugal Flowing We		scribe):		
Date Pump Installed: 5-20-13				
Is This Pump (circle one): New Repaired Replace				
Power	Type (circle one)			
Electric Diesel Gasoline Natural Gas Tractor PTO				
Horse Power Rating of Motor: Setting Depth:feet Number of Stages:				
Pump Test Data for Non Flowing Well				
Date Well Tested: hours Duration of Pump Test (<i>minimum 4 hours</i>): hours				
Static Water Level (A): Feet Below Land Surface Pumping Water Level (B): Feet Below Land Surface				
Drawdown [(B) - (A)]:Feet Below Land Surface Test Pumping Rate: Gallons Per Minute				
Method of measurement (circle one): Steel tape Electri				
Pump Test Data for Flowing Well				
Measured shut in head:feet.				
Well yieldedGPM with a drawdown of feet afterhours of pumping				
	er Installation			
Meter Manufacturer: Meter Serial Number:/3-00387				
Meter Model Number/Name:M0310 Type of Meter:MECHANICAL				
Totalizer Register Unit and Multiplier Factor (AF \times .001,	•			
Installation Date: <u>5-25-13</u> Meter installed b		JGATTON		
Is This Meter (circle one): New Repaired Replace	ment	RECEIVED		
Important: By submitting the above information you are For agricultural wells, a list of	certifying that this meter was instal approved meters is on the MDEQ wa	lled to manufacturer standards. JUN 05 2013		
I HEREBY CERTIFY that the above statements are true to	the best of my knowledge	The IA DI COLLAND		
Print Name of Pump Installer and License No. (<i>if applicable</i>) Date Signature of Pump Installer				
		13-0351		
		1010		