

STATE WELL REPORT

Part 1

Driller's Log

Mississippi Department of Environmental Quality
Office of Land and Water Resources
P.O. Box 2309
Jackson, MS 39225-2309
(601)961-5210
(601)360-0535 (fax)

For Office Use Only:

Well #: H 174
Aquifer: _____
E-Log #: _____

County: LeFlore
Permit #: GW-47135
Driller: Joel Jumper
Date drilling completed: 5-14-13

State Law requires that this report be prepared by the license holder responsible for the work and filed with the Department at the above address within 30 days of completion of drilling of the well or borehole.

Well Owner Information <small>(Landowner if borehole is not for a water well)</small>	Well or Borehole Location
Owner Name: <u>ASA Bennett</u>	Latitude: <u>33-37-17</u> Longitude: <u>90-12-11</u>
Mailing Address: <u>605 Robert E Lee Drive</u>	Method of Lat/Long (check one): Conventional Survey _____
<u>Greenwood</u> <u>Ms</u> <u>38930</u>	USGS quad _____, Hand-held GPS <input checked="" type="checkbox"/> , Survey-grade GPS _____
City State Zip Code	<u>SW</u> $\frac{1}{4}$ <u>SW</u> $\frac{1}{4}$, Sec <u>04</u> T <u>20N</u> R <u>01E</u>
Telephone No. (____) _____	<u>2</u> Miles <u>S</u> of <u>Money</u>
	(Distance) (Direction) (Nearest Town)

Well / Borehole Data

Date drilling started: 5-14-13 Date drilling completed: 5-14-13 Hole depth: 108 Hole diameter: 2 1/2 in

Location of the source of any surface water used for drilling: Nearest Well

Method of dosing and volume of Chlorine used in drilling and development: _____

Logs run (circle all applicable): No log run Electric Gamma Ray Density Sonic Neutron Other: _____

Name of organization running log(s): _____

Purpose of borehole (circle one): Water Well Geotechnical/Geological Investigation Ground Source Heat Pump
 Seismic Survey Other (describe) _____

If drilling is not related to water well construction, skip the remainder of this block

Purpose of Well (circle all applicable): Home Industrial Public Supply Irrigation Fish Culture

Other (describe): _____

If a flowing well, method of flow regulation: Valve _____ Other (describe) _____

Static Water Level: 18 feet [above or below] land surface Date measured: 5-14-13
(circle one)

Method of measurement (circle one): Steel tape Electric tape Air line Other (describe): _____

Well depth: 108 Well grouted to a depth of: 10 feet Type of grout (circle one): Neat Cement Bentonite Mix

Casing length: 68 feet Casing diameter: 1 1/2 inches Type of casing: PVC

Screen length: 40 feet Screen diameter: 1 1/2 inches Type of screen: RECEIVED

Screen slot size: 0.50 inches Setting depth: From 0.68 feet to 70 108 feet

Type of completion (circle all applicable): Gravel packed Underreamed Open hole Natural Development

Other (describe): _____

Top of lap pipe or reduction in casing: _____ feet


If telescoped or more than one screen, describe on next page

RECEIVED
JUN 23 2013
BY: OLWR

H174

The sketch below only required for water wells

If well telescopes, show depths on sketch.

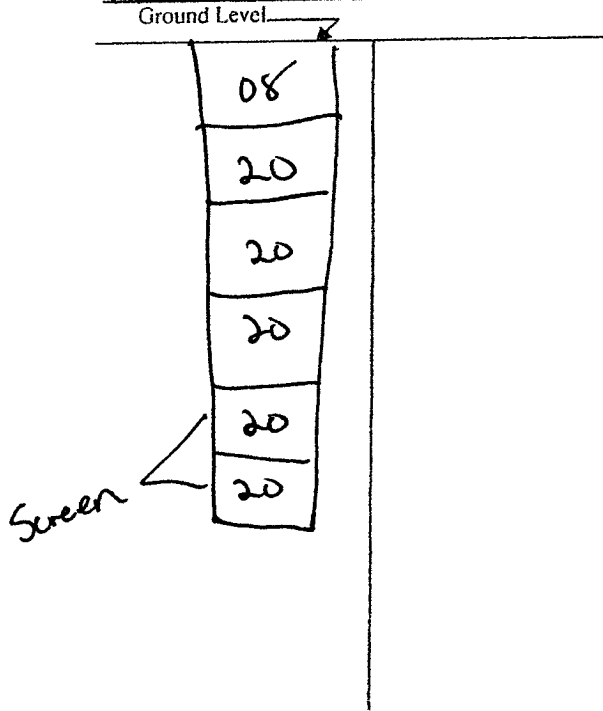

Description of formations encountered must be provided for all wells and boreholes unless specifically exempted by regulations

Description of Formations Encountered	From (depth)	To (depth)
Clay	Ground Level	20
Sand	20	40
Coarse sand	40	60
Coarse sand	60	80
Coarse sand	80	100
Sand + gravel	100	108

If more than one screen, show location of each on sketch

Sketch the property layout and include the following: 1) the well location; 2) any permanent structures on the property that may aid in locating the well; 3) any roads, power lines, or other items that may aid in locating the property and the well; 4) a north arrow.

A hand-drawn sketch of a property layout. A vertical line represents "Money Rd". A horizontal line crosses it. To the right of the vertical line, a dot is labeled "well". Above the vertical line, another dot is labeled "Money". A north arrow is drawn above "Money". The sketch is enclosed in a rectangular box.

RECEIVED
JUN 13 2013
BY: OLWR

Landowner Name: ASA Bennett

Form: OLWR-SWR-1A (04/08)

I certify that the well/borehole was drilled, constructed, and completed in accordance with all applicable requirements of the Mississippi Department of Environmental Quality and the Mississippi Department of Health regulations, if applicable, and state laws.

Joel Jumper 5317 5-14-13 Joel Jumper
Print Name of Responsible Licensee and License No. Date Signature of Licensee

STATE WELL REPORT

Part 2

Pump Installer's Completion Report
 Mississippi Department of Environmental Quality
 Office of Land and Water Resources
 P.O. Box 2309
 Jackson, MS 39225-2309
 (601)961-5210
 (601) 360-0535 (fax)

County: LEFLORE
 Permit #: GW-47135
 Driller: JOEL JUMPER
 Date completed: 5-14-13
 Copy information from block on Part 1

For Office Use Only:

Well #: H174
 Aquifer: _____

This part of the report must be completed by a licensed water well contractor or a licensed pump installer. A copy of Part 1 of the report must be attached and both parts filed with the Department at the above address within 30 days of well completion.

Well Owner Information	Well Location
Owner Name: <u>PARE BONES FARMS</u>	Latitude: <u>33° 37' 17"</u> Longitude: <u>90° 12' 11"</u>
Mailing Address: <u>605 ROBERT E. LEE DR</u>	Method of Lat/Long (check one): Conventional Survey _____, USGS quad _____, Hand-held GPS _____, Survey-grade GPS _____
<u>GREENWOOD</u> <u>MS</u> <u>38930</u>	<u>SW</u> ¼ <u>SW</u> ¼, Sec <u>04</u> T <u>20N</u> R <u>01E</u>
City State Zip Code	<u>2</u> Miles <u>S</u> of <u>MONEY</u>
Telephone No. (<u>662</u>) <u>453-0504</u>	(Distance) (Direction) (Nearest Town)

Pump Type (circle one)

Submersible Turbine Air Lift Centrifugal Flowing Well Jet Piston Rotary Other (describe): _____

Date Pump Installed: 6-14-13 Rated Pump Capacity: 3000 Gallons Per Minute

Is This Pump (circle one): New Repaired Replacement

Power Type (circle one)

Electric Diesel Gasoline Natural Gas Tractor PTO Windmill Other (describe): _____

Horse Power Rating of Motor: 60 Setting Depth: 70 feet Number of Stages: 1

Pump Test Data for Non Flowing Well

Date Well Tested: _____ Duration of Pump Test (minimum 4 hours): _____ hours

Static Water Level (A): 16 Feet Below Land Surface Pumping Water Level (B): _____ Feet Below Land Surface

Drawdown [(B) - (A)]: _____ Feet Below Land Surface Test Pumping Rate: _____ Gallons Per Minute

Method of measurement (circle one): Steel tape Electric tape Air line Other (describe): _____

Pump Test Data for Flowing Well

Measured shut in head: _____ feet.

Well yielded _____ GPM with a drawdown of _____ feet after _____ hours of pumping

Meter Installation

Meter Manufacturer: McComstar Meter Serial Number: 13 00383

Meter Model Number/Name: M0310 Type of Meter: Mechanical


Totalizer Register Unit and Multiplier Factor (AF x .001, gal x 1000, etc): _____

Installation Date: 6-15-13 Meter installed by: CIRCLE SIRRIGATION

Is This Meter (circle one): New Repaired Replacement

Important: By submitting the above information you are certifying that this meter was installed to manufacturer standards. For agricultural wells, a list of approved meters is on the MDEQ website.

I HEREBY CERTIFY that the above statements are true to the best of my knowledge.

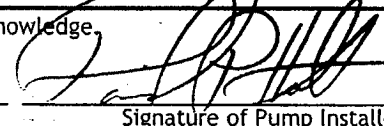DAVID P. HOLT 0-752P 7-8-13 

Print Name of Pump Installer and License No. (if applicable) Date Signature of Pump Installer

RECEIVED
 JUL 11 2013
 BY: OLWR

13-0349