

Leflore
H2000

**MISSISSIPPI
BOARD OF WATER COMMISSIONERS**
416 North State Street
Jackson, Mississippi 39201

WATER WELL DRILLERS LOG

3-2 1977 Lipe Well Co Leflore
date well completed firm name county well located

LANDOWNER:	description of formations encountered	from	to
<u>GIM Hill</u>			
<u>Grenada Ms.</u> (mailing address)	<u>Sand</u>	<u>20</u>	<u>40</u>
	<u>Sand and Gravel</u>	<u>40</u>	<u>100</u>
WELL LOCATION: sec. <u>21</u> T. <u>20</u> N. R. <u>1</u> E. <u>5</u> miles <u>North Greenwood</u> (distance) (direction) (nearest town)	<u>Clay</u>	<u>100</u>	<u>160</u>
	<u>Sand</u>	<u>160</u>	<u>180</u>
	<u>Clay</u>	<u>180</u>	<u>200</u>
	<u>"</u>	<u>200</u>	<u>240</u>
	<u>Sand and Clay</u>	<u>240</u>	<u>260</u>
	<u>" " " "</u>	<u>260</u>	<u>300</u>
	<u>Sand</u>	<u>300</u>	<u>320</u>

WELL PURPOSE:
(home, irrigation, municipal, industrial)

- WELL COMPLETION DATA:
- (1) diameter (inches) 4"
 - (2) total depth (feet) 320
 - (3) static water level (feet) flowing ^{below} _{above} top of ground.
 - (4) casing PVC 155'
(material) (depth)
 - 4
(size) if telescope see back.
 - (5) screen 20 300
(length) (depth to top)
 - 2 PVC
(size) (material)
 - (6) pump flowing 33 PPM
(HP) (yield gpm)
 - NO
(type power)
 - (7) electric log NO
(yes or no)
 - NO
(organization running log)
 - (8) how well bottom plugged PVC
plug


DRILLERS REMARKS:

RECEIVED
APR 20 1977

MISS. BD. OF WATER COMM

If well telescopes please sketch and show depths.

GROUND LEVEL

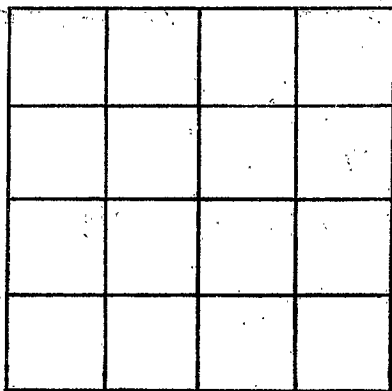

SECTION _____

Please indicate well location X.

ADDITIONAL INFORMATION

If more than one screen,
show locations of each on sketch.