

Leflore
H 2009
2-15-80

MISSISSIPPI
BOARD OF WATER COMMISSIONERS
416 North State Street
Jackson, Mississippi 39201

WATER WELL DRILLERS LOG
BUTANE GAS COMPANY

2-15-80
date well completed

OF GREENWOOD

Leflore
county well located

LANDOWNER:	description of formations encountered	from	to
MRS. E. H. Neill	Clay	0	18
AVALON	CLAY SAND	18	80
(mailing address)	SAND & GRAVEL	80	140
WELL LOCATION:	Clay	140	200
sec. <u>5</u> T. <u>20</u> N. R. <u>2</u> E.	SAND, SHALE, CLAY	200	420
<u>5 1/2</u> miles <u>SE</u> of <u>Money</u>	Clay	420	490
(distance) (direction) (nearest town)	SAND	490	525
WELL PURPOSE: <u>Home</u>			
(home, irrigation, municipal, industrial)			
WELL COMPLETION DATA:			
(1) diameter (inches) <u>4x2</u>			
(2) total depth (feet) <u>513</u>			
(3) static water level (feet) <u>10</u> ^{below} / <u>10</u> ^{above} top of ground.			
(4) casing <u>Steel</u> , <u>493</u>			
(material) (depth)			
<u>4x2</u> (size) if telescope see back.			
(5) screen <u>20'</u> , <u>493</u>			
(length) (depth to top)			
<u>2"</u> , <u>Stainless</u>			
(size) (material)			
(6) pump <u>1/2</u> , <u>10</u>			
(HP) (yield gpm)			
<u>Elec</u>			
(type power)			
(7) electric log <u>NO</u>			
(yes or no)			
(organization running log)			
(8) how well bottom plugged <u>Back Pressure Valve</u>			
DRILLERS REMARKS:			

DEPT. OF NATURAL RESOURCES
BUREAU OF LAND & WATER RESOURCES

FEB 25 1980

RECEIVED


If well telescopes please sketch and show depths.

GROUND LEVEL

105' - 4" CASING →

473' - 2" CASING →

20' - 2" SCREEN

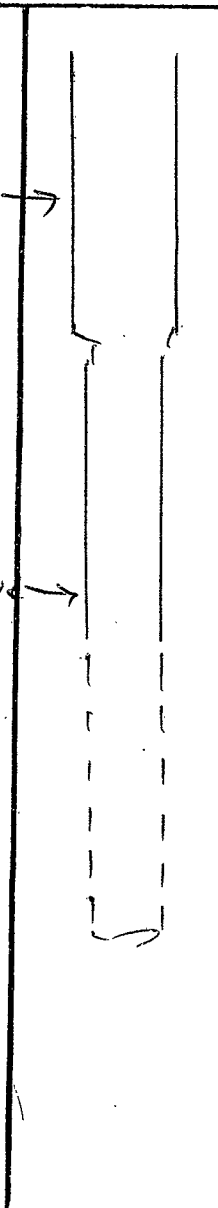

		X	

SECTION 5

Please indicate well location X.

ADDITIONAL INFORMATION

If more than one screen, show locations of each on sketch.