

MISSISSIPPI DEPARTMENT OF NATURAL RESOURCES

Bureau of Land and Water Resources

Southport Mall

P.O. Box 10631

Jackson, Mississippi 39209

WATER WELL DRILLERS LOG

BUTANE GAS COMPANY

OF GREENWOOD

*Leflore*  
*H 2003*

*Leflore*

*3-20* 19 *83*  
date well completed

county well located

LANDOWNER:  
*Pittman Farms*  
(mailing address)

description of formations encountered	from	to
<i>CLAY</i>	<i>0</i>	<i>35</i>
<i>SAND</i>	<i>35</i>	<i>60</i>
<i>Sand + gravel</i>	<i>60</i>	<i>105</i>

WELL LOCATION:  
sec. *24* T. *20* N. R. *1* E.  
*3* miles *NW* of *Greenwood*  
(distance) (direction) (nearest town)

WELL PURPOSE: *Farm*  
(home, irrigation, municipal, industrial)

- WELL COMPLETION DATA:
- (1) diameter (inches) *4"*
  - (2) total depth (feet) *105'*
  - (3) static water level (feet) *12* <sup>below</sup> above top of ground.
  - (4) casing *P.V.C.* *65'*  
(material) (depth)  
*4"*  
(size) if telescope see back.
  - (5) screen *20'* *65'*  
(length) (depth to top)  
*4"* *P.V.C.*  
(size) (material)
  - (6) pump *1.5* *30*  
(HP) (yield gpm)  
*Elect*  
(type power)
  - (7) electric log *No*  
(yes or no)  
*No*  
(organization running log)

(8) how well bottom plugged  
*Back well Valve*

DRILLERS REMARKS:  
*Richard West*


DEPT. OF NATURAL RESOURCES  
BUREAU OF LAND & WATER RESOURCES

APR 29 1984

RECEIVED

If well telescopes please sketch and show depths.

GROUND LEVEL

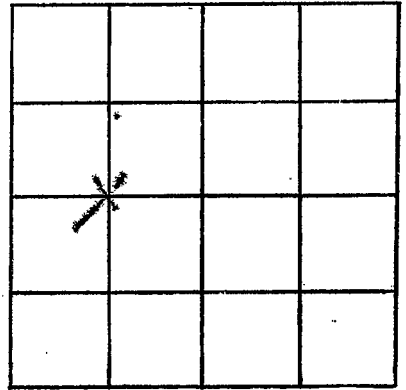

SECTION 29

Please indicate well location X.

ADDITIONAL INFORMATION

If more than one screen, show locations of each on sketch.