

MISSISSIPPI DEPARTMENT OF ENVIRONMENTAL QUALITY

Office of Land and Water Resources

P. O. Box 10631
Jackson, MS 39289-0631
WATER WELL DRILLERS LOG

COUNTY WELL LOCATED LeFlore	
WELL NUMBER # 2008	CODED
DATE WELL COMPLETED 7-10-93	

PERMIT NUMBER
NAME OF DRILLING FIRM IRRIGATION EQUIPMENT
601/887-2555
INDIANOLA, MS

NAME & MAILING ADDRESS OF LANDOWNER W. M. Gullledge + CO.		
723 Sumner AVE.		
Greenwood, ms		
WELL LOCATION:	SEC	TOWNSHIP
SW/NE	21	20
	N	E
	S	1
DISTANCE	DIRECTION	NEAREST TOWN
4	North	Greenwood
OTHER LANDMARK		
WELL PURPOSE: Home, Irrigation, Municipal, Industrial, Fish Pond, etc. Irrigation - Pivot		

PUMP DATA		
PUMP TYPE (Circle One): Submersible, Turbine , Jet, Flowing Well, Other (Describe) _____		
POWER TYPE (Circle One): Electric, tractor , Diesel, Gasoline, Butane, Other (Describe) _____ H/P 60		
Pump Capacity (GPM) 450	No. of Stages 9	Setting Depth 50 FT.
PUMP TEST		
Well yielded _____ GPM with a drawdown of _____ ft. after _____ hours of pumping		

WELL DATA		
Well Depth 99	Casing Diameter (In.) 10	Casing Length (Ft.) 59
Type of Casing PVC	Hole Depth 99	Depth to Static Water Level 16'
TYPE OF COMPLETION: (Circle One or More): Cravel Packed , Underreamed, Telescoped, Natural Development, Open Hole, Other (Describe) _____		

LOG DATA	
TYPE OF LOG RUN (Circle One): Electric, Gamma Ray, Density, Sonic, Neutron, Other (Describe) _____ No Log Run,	
Name of Organization Running Log	

WELL GROUTED TO A DEPTH OF _____ FEET Type Grout (circle one): Cement, Bentonite, or Mix

GEOLOGIC DATA (Office Use Only)			
Surface Elev.	Geologic Unit	Unit Thickness	Depth to Top
Subs. SWL	Date	Analysis	Aquifer Test

SCREEN DATA		
Diameter - Inches 10	Length - Feet 40	Slot Size - Inches #30
Screen Type PVC	Depth to Bottom - Feet 99	


Driller's Remarks Big-D

DESCRIPTION OF FORMATIONS ENCOUNTERED	FROM	TO
Soil	0	5
Fine SAND	5	20
medium + COARSE	20	45
COARSE + GRAVEL	45	99

FORMATIONS (Continued)	FROM	TO
RECEIVED		
AUG 17 1993		
Dept. of Environmental Quality Office of Land & Water Resources		
IF MORE SPACE IS NEEDED, USE BACK		

If well telescopes please sketch and show depths.

GROUND LEVEL

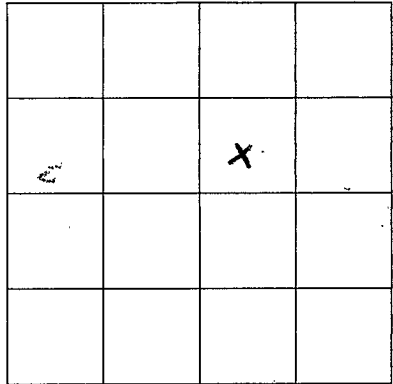

SECTION 21

Please indicate well location X.

ADDITIONAL INFORMATION

If more than one screen,
show location of each on sketch.