

County: Leflore
 Permit #: _____
 Driller: Irrigation Equipment
 Date drilling completed: 9-2-11

State Well Report
Part 1 - Driller's Log
 Mississippi Department of Environmental Quality
 Office of Land and Water Resources
 P.O. Box 2309
 Jackson, MS 39225
 (601)961- 5210
 (601)961- 5228 (fax)

For Office Use Only:
 Aquifer: J185
 Well #: _____
 L. S. Elevation: 114
 E-log #: _____

State Law requires that this report be prepared by the license holder responsible for the work and filed with the Department at the above address within 30 days of completion of drilling of the well or borehole.


Information on Well Owner
 (Landowner if borehole is not for a water well)
 Owner Name America's Catch
 Mailing Address: 22550 County Road 507
Itta Bena MS 38941
 City State Zip Code
662-458-9253 Noel
 Telephone No. () Barrett
662-254-7200

Well or Borehole Location
 Latitude: 33° 32' 24.9" Longitude: 90° 25' 49.4"
 Method of Lat/Long (circle one): Conventional Survey
 USGS quad, Hand-held GPS, Survey-grade GPS
NE 1/4 SW 1/4 Sec 5 Twn 19N Rng 2W
 Distance Direction Nearest Town
6 Miles NW of Itta Bena

Well / Borehole Data
 Date drilling started: 9-2-11 Date drilling completed: 9-2-11 Hole depth: 121 Hole diameter: 24"
 Location of the source of any surface water used for drilling: Surface Water
 Method of dosing and volume of Chlorine used in drilling and development: 50 PPM
 Logs run (circle all applicable): No log run Electric Gamma Ray Density Sonic Neutron Other: _____
 Name of organization running log(s): _____
 Purpose of borehole (check one): Water Well Geotechnical/Geological Investigation _____ Ground Source Heat Pump _____
 Seismic Survey _____ Other (describe) _____
If drilling is not related to water well construction, skip the remainder of this block
 Purpose of Well (check one): Home _____ Industrial _____ Public Supply _____ Irrigation Fish Culture _____ Other: Replacement
 If a flowing well, method of flow regulation: Valve _____ Other (describe) _____
 Static Water Level: 63 feet above or below (circle one) land surface Date measured: 9-6-11
 Method of Measurement (circle one) steel tape electric tape air line other: _____
 Well depth: 121 Well grouted to a depth of 10 feet Type of grout (circle one): Neat Cement Bentonite Mix
 Casing length: 81 feet Casing diameter: 16 inches Type of casing: PVC
 Screen length: 40 feet Screen diameter: 16 inches Type of screen: PVC
 Screen slot size: See back inches Setting depth: From See back feet to _____ feet
 Type of completion (circle all applicable): Gravel packed Underreamed Telescoped Open hole Natural Development
 Other (describe): _____
 Top of lap pipe or reduction in casing: _____ feet. *If telescoped or more than one screen, describe on next page*

Form: OLWR-SWR-1A (04/08)

RECEIVED
 OCT 11 2011
 BY: OLWR

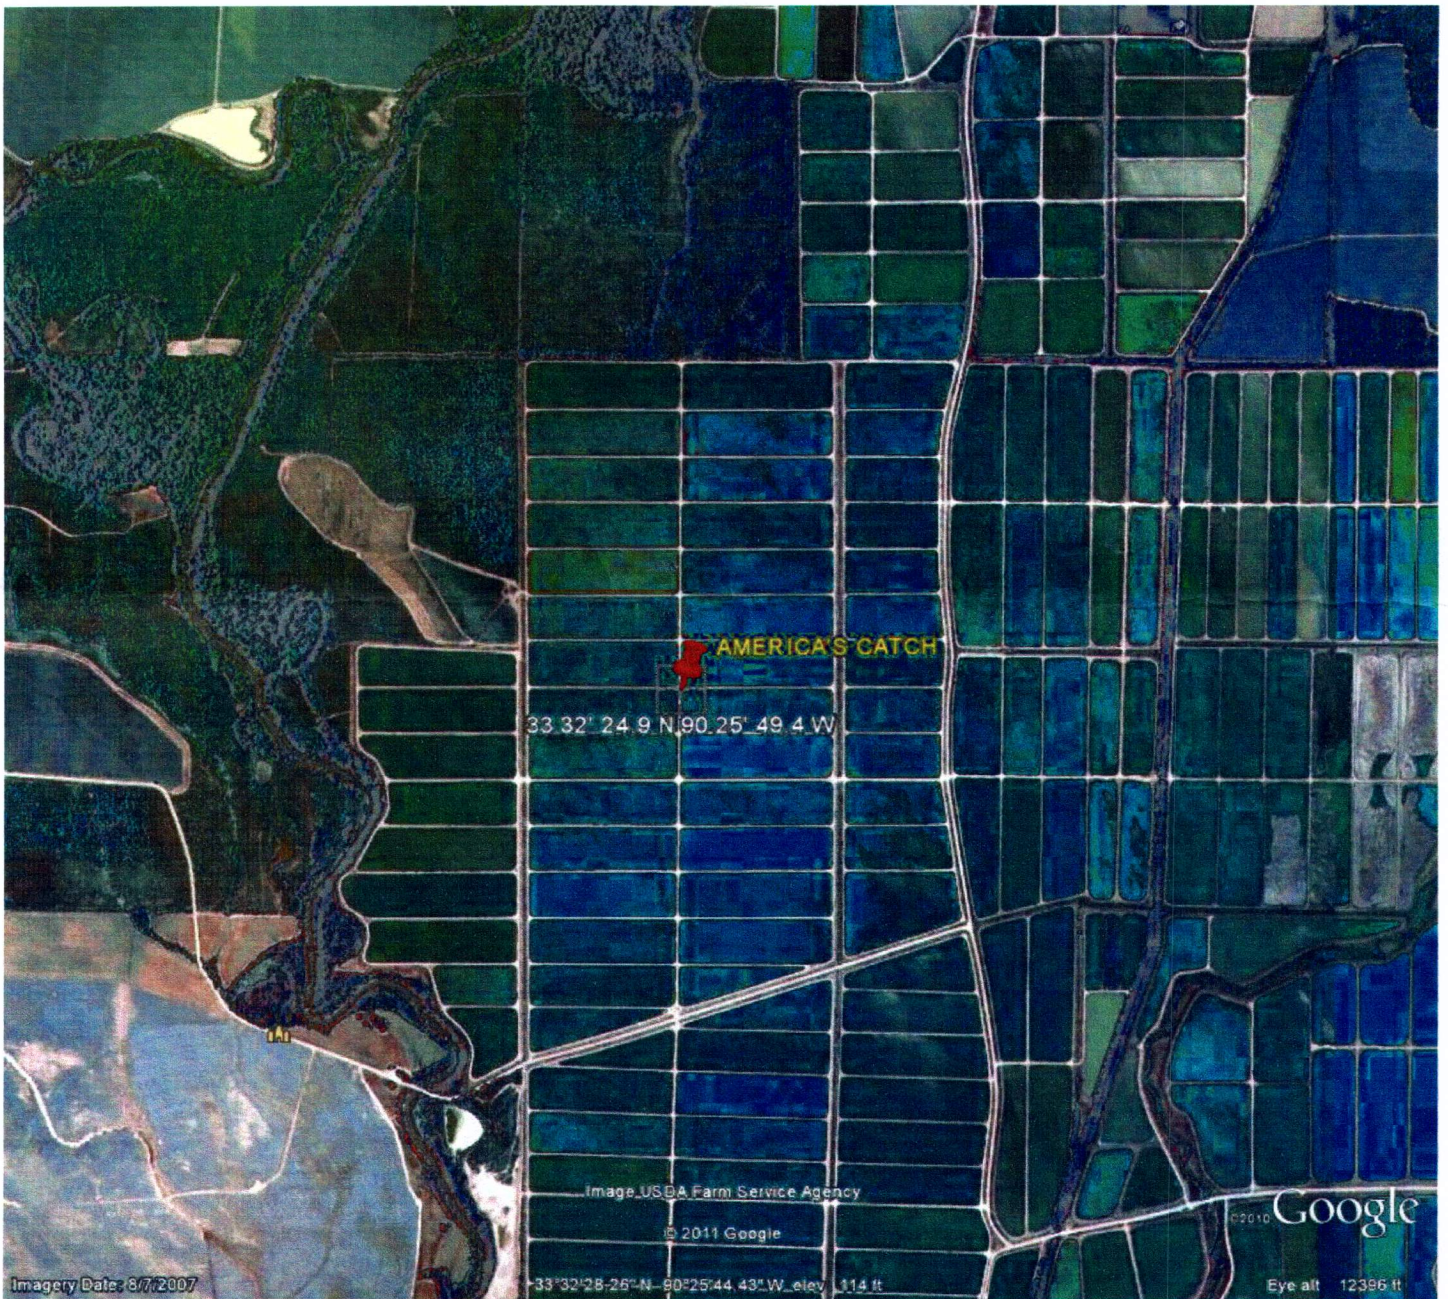

RECEIVED
OCT 11 2011
BY: OLWR