

Le flore
J
879

MISSISSIPPI
 BOARD OF WATER COMMISSIONERS
 416 North State Street
 Jackson, Mississippi 39201

WATER WELL DRILLERS LOG

August 19 79 Delta Drilling Co. LeFlore
 date well completed firm name county well located

LANDOWNER: Mrs. Mary Johnson
 Rt 1, Box 37
 Greenwood, Ms. 38930
 (mailing address)

WELL LOCATION:
 sec. 29 T19 N R 2 E S
 approx 3 miles SE of Greenwood
 (distance) (direction) (nearest town)

WELL PURPOSE: Domestic
 (home, irrigation, municipal, industrial)

- WELL COMPLETION DATA:
- (1) diameter (inches) 4" x 2"
 - (2) total depth (feet) 435
 - (3) static water level (feet) _____ below above top of ground.
 - (4) casing steel 435
 (material) (depth)
4" (10.5") x 2" (3.5")
 (size) if telescope see back.
 - (5) screen 2 1/2 perforated 20'
 (length) (depth to top)
2"
 (size) (material)
 - (6) pump 1 500
 (HP) (yield gph)
Elec.
 (type power)
 - (7) electric log _____
 (yes or no)

 (organization running log)
 - (8) how well bottom plugged back pressure
valve


description of formations encountered	from	to
SAND	0	86
Gravel	80	120
SAND	120	220
Gumbo-shale w/ rock	230	260
Green sand	260	286
SHALE	286	300
SAND	300	322
Shale + SAND	322	339
SAND	339	439

Rec'd 9-25-79
 Dm

DRILLERS REMARKS:

If well telescopes please sketch and show depths.

GROUND LEVEL

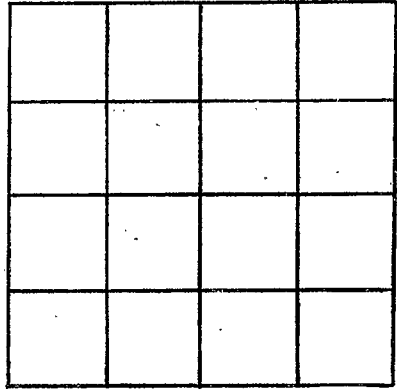

SECTION _____

Please indicate well location X.

ADDITIONAL INFORMATION

If more than one screen, show locations of each on sketch.