

WATER WELL DRILLERS LOG

CODED

Lefflore

Date: MAR 28, 1964, Driller: DELTA DRILLING Co. County: LEFFLORE

J-2

(Name)

3-28-64
(1) Owner of Land: GEO W. LEWIS
(Name)

BERCLAIR, MISS.
(Address)

(2) Location: 1/4, 1/4, Sec. 36 T19 R24W
_____ miles _____ of _____
(distance) (direction) (Nearest Town)

(3) Topography: _____
(Hilly) (Flat) (Level)

(4) Purpose of Well: DOMESTIC
(Domestic Irrigation
Municipal, Industrial, Other)

Description & Color of Materials Sand, Clay, Red Clay, Shell, etc.	Thick- ness Feet	Depth Feet
SANDY GRAY SOIL	14	14
SAND	60	74
GRAVEL	75	149
GUMBO	60	209
SAND	62	271
GUMBO	92	363
SHALE	33	396
GUMBO	170	566
SHALE W/ROCKS.	28	594
GREEN SAND W/ROCKS.	97	691
SHALE W/ROCKS.	48	719
SHALE W/ROCKS.	60	779
GREEN SAND.	48	827
GUMBO	12	839
SHALE	60	899
SAND W/ROCKS.	78	977
GUMBO	32	1009
SHALE	92	1081
SAND	8	1089
SHALE	6	1095
SAND	38	1133
SHALE	4	1137

Information upon completion of well:

(1) Diameter 3 inches.

(2) Total Depth 1137 feet.

(3) Water Level FLOWS feet below top of ground.

(4) Cased to 1113, Size 4 1/2" - 2"
1135

(5) Screen: Size 2", Length 210'

(6) Were any formations sealed against pollution?
_____ yes, no.


If YES depth of formation _____

Why _____

Drillers Remarks: 22' LAP OF 2" IN

3" PIPE - 4' 2" TAIL PIPE ON
BOTTOM END OF WELL. 1-
10' SECTION OF SCREEN SET
AT 1092' 1- SET AT 1123'

CODED

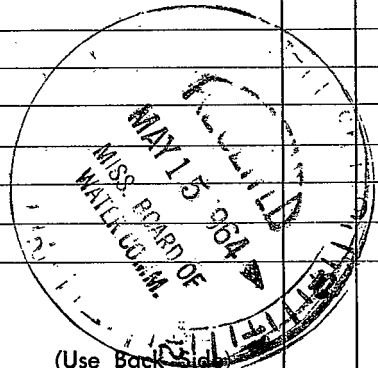

(Use Back Side)

Well No.

1877

2

1877

1877