

Leflore
J 17
12-8-62

MISSISSIPPI BOARD OF WATER COMMISSIONERS

WATER WELL DRILLERS LOG CODED

Date: DEC. 8, 1962, Driller: DELTA DRILLING Co. County: LEFLORE

(Name)

(1) Owner of Land: MRS. ELAINE KIMBLE
M.R.C.D. REICH
(Name)

ITTA BENA, MISS.
(Address)

(2) Location: NE 1/4, SE 1/4, Sec. 23 T22N R2E W
_____ miles _____ of _____
(distance) (direction) (Nearest Town)

(3) Topography: _____
(Hilly) (Flat) (Level)

(4) Purpose of Well: DOMESTIC
(Domestic Irrigation
Municipal, Industrial, Other)

Description & Color of Materials Sand, Clay, Red Clay, Shell, etc.	Thick- ness Feet	Depth Feet
GUMBO	40	40
SAND	32	72
GRAVEL	47	119
SAND	73	192
GUMBO	64	256
SAND	83	339
SHALE CODED	82	421
SAND	42	463
SHALE	82	545
GUMBO	22	567
GREEN SAND W/ROCK	102	669
SHALE W/ROCK	35	704
GREEN SAND W/ROCKS	86	780
SHALE	16	796
GREEN SAND	12	808
BROWN SAND	82	890
SHALE W/ROCKS	83	973
SAND	12	985
SHALE	18	1003
GUMBO	36	1039
SHALE	31	1070
SAND	20	1090
GUMBO	16	1106
SAND	94	1200

Information upon completion of well:

(1) Diameter 3 inches.

(2) Total Depth 1200 feet.

(3) Water Level WELL FLOWS feet below top of ground.


(4) Cased to 1170', Size 693 L 3" / 504' - 2"

(5) Screen: Size 2", Length 30'

(6) Were any formations sealed against pollution?
_____ yes, _____ no.

If YES depth of formation _____
Why _____

Drillers Remarks: 27' LAP OF 2" IN 3" PIPE. WELL FLOWS 65 G.P.M. 15# PRESSURE-

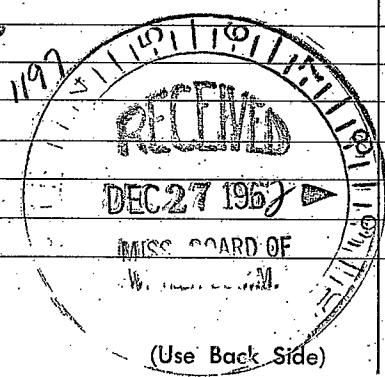

(Use Back Side)

Well No.

