

Leflore
J20
8-1-63

MISSISSIPPI BOARD OF WATER COMMISSIONERS

CODED

WATER WELL DRILLERS LOG

Date: AUG. 1, 1963, Driller: DELTA DRILLING Co. County LEFLORE

(Name)

(1) Owner of Land: DR. A.F. CHARLTON
(Name)

BERCLAIR, MISS
(Address)

(2) Location: S.W. 1/4, NW 1/4, Sec. 36 TANRZ-W

_____ miles _____ of _____
(distance) (direction) (Nearest Town)

(3) Topography: _____
(Hilly) (Flat) (Level)

(4) Purpose of Well: DOMESTIC -
(Domestic Irrigation
Municipal, Industrial, Other)

Information upon completion of well:

(1) Diameter 3 inches.

(2) Total Depth 1141 feet.

(3) Water Level FLOWS feet below top of ground.
693'-3"

(4) Cased to 1121, Size 440'-2"

(5) Screen: Size 2", Length 20'


(6) Were any formations sealed against pollution?
_____ yes, _____ no.

If YES depth of formation _____

Why _____

Drillers Remarks: 13' LAP OF 2" IN 3" PIPE

Description & Color of Materials Sand, Clay, Red Clay, Shell, etc.	Thick- ness Feet	Depth Feet
GUMBO -	22	22
SAND	64	86
GRAVEL	43	129
GUMBO	144	273
SAND	20	293
GUMBO	12	305
SHALE	15	320
GUMBO	36	356
SAND	32	388
SHALE	8	396
GUMBO	131	527
SHALE W/ROCKS	86	613
SAND	63	676
SHALE W/ROCKS-	50	726
SAND W/ROCKS	60	786
SHALE	70	856
SAND & ROCKS	40	896
SHALE W/ROCKS-	50	946
SAND	30	976
GUMBO	22	998
SHALE	28	1026
GUMBO	12	1038
SHALE	28	1066
WHITE SAND	61	1127
SHALE	14	1141

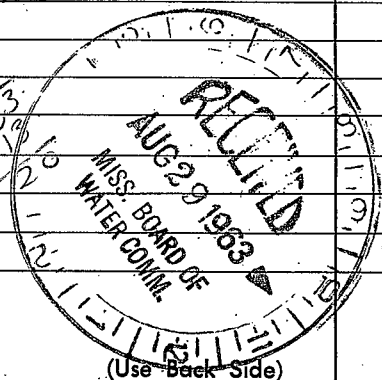

Well No.

