

LEFLORE

J29

1-28-74

MISSISSIPPI
 BOARD OF WATER COMMISSIONERS
 416 North State Street
 Jackson, Mississippi 39201

CODED

WATER WELL DRILLERS LOG

1-28 1974 DYER WELL & IRRIGATION SERVICE LEFLORE
 date well completed firm name county well located

LANDOWNER: DAVID RICE
 GEORGE RICE

description of formations encountered

from

to

INDIANOLA MISS
 (mailing address)

CLAY	0	23
SAND	23	40
SAND GRAVEL	40	98

WELL LOCATION:

sec. 3 T. 19 N R. 2 E
 5 miles N.W. of BENIA
 (distance) (direction) (nearest town)

WELL PURPOSE: FIRE.
 (home, irrigation, municipal, industrial)

WELL COMPLETION DATA:

(1) diameter (inches) 16"
 (2) total depth (feet) 98'
 (3) static water level (feet) 14' below top of ground.

(4) casing BXC IN. 58'
 (material) (depth)
 16" If telescope see back.
 (size)

(5) screen 40' 48'
 (length) (depth to top)
 16" BXC IN. NET
 (size) (material)

(6) pump 600 300.0
 (HP) (yield gpm)

ELEC.
 (type power)

(7) electric log No
 (yes or no)

(organization running log)

(8) how well bottom plugged PLUG

CODED


RECORDED
 INDEXED

FEB 14 1974

DRILLERS REMARKS:

If well telescopes please sketch and show depths.

GROUND LEVEL

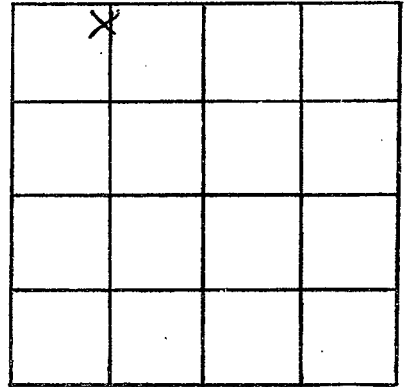

SECTION 3

Please indicate well location X.

ADDITIONAL INFORMATION

If more than one screen, show locations of each on sketch.