

LEFLORE

J31

1-16-74

MISSISSIPPI
 BOARD OF WATER COMMISSIONERS
 416 North State Street
 Jackson, Mississippi 39201

CODED

WATER WELL DRILLERS LOG

1-16
date well completed

1974 DYER WELL & IRRIGATION SERVICE
firm name

LEFLORE
county well located

LANDOWNER: GEORGE RICE
INDIANOLA,
MISS
 (mailing address)


description of formations encountered	from	to
CLAY	0	47
SAND GRAVEL	47	83
FINE SAND	83	100
GRAVEL	100	113

WELL LOCATION:
 sec. 4 T. 19 N. R. 2 W.
5 1/2 miles NO. of ITTA BENA
 (distance) (direction) (nearest town)

WELL PURPOSE: IRRIGATION
 (home, irrigation, municipal, industrial)

- WELL COMPLETION DATA:
- (1) diameter (inches) 16"
 - (2) total depth (feet) 113
 - (3) static water level (feet) 14 1/2 below top of ground.
 - (4) casing BURIA, 93'
 (material) (depth)
16" if telescope see back.
 (size)
 - (5) screen 40', 73'
 (length) (depth to top)
16", BK FIBER
 (size) (material)
 - (6) pump 60 3,000
 (HP) (yield gpm)
ELEC.
 (type power)
 - (7) electric log NO
 (yes or no)
 (organization running log)
 - (8) how well bottom plugged PLATE

CODED

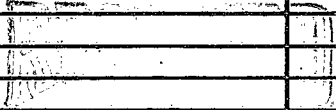

FEB 14 1974

DRILLERS REMARKS:

MISS. DE. OF WATER COMM

