

LEFLORE
J 33
1-15-74

MISSISSIPPI
 BOARD OF WATER COMMISSIONERS
 416 North State Street
 Jackson, Mississippi 39201

WATER WELL DRILLERS LOG

CODED

1-15 date well completed 19 74 DYER WELL & IRRIGATION SERVICE firm name LEFLORE county well located

LANDOWNER: David Rice
GEORGE RICE
INDIANOLA,
MISS
 (mailing address)

description of formations encountered	from	to
	CLAY	0
SAND	23	41
SAND GRAVEL	41	98


WELL LOCATION:
 sec. 4 T. 19 N R. 2 W
5 1/2 miles NW of INDIANOLA
 (distance) (direction) (nearest town)

WELL PURPOSE: IRR.
 (home, irrigation, municipal, industrial)

WELL COMPLETION DATA:

- (1) diameter (inches) 16"
- (2) total depth (feet) 98'
- (3) static water level (feet) 14' below above top of ground.
- (4) casing Pvc, 58'
 (material) (depth)
16" If telescope see back.
 (size)
- (5) screen 40', 58'
 (length) (depth to top)
16", BUCKINGHAM
 (size) (material)
- (6) pump ELEC., 3000
 (HP) (yield gpm)
ELEC.
 (type power)
- (7) electric log No
 (yes or no)
- (organization running log)
- (8) how well bottom plugged Pvc

CODED

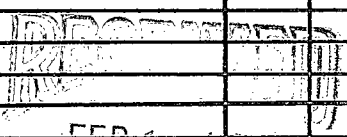


FEB 14 1974

DRILLERS REMARKS:

If well telescopes please sketch and show depths.

GROUND LEVEL

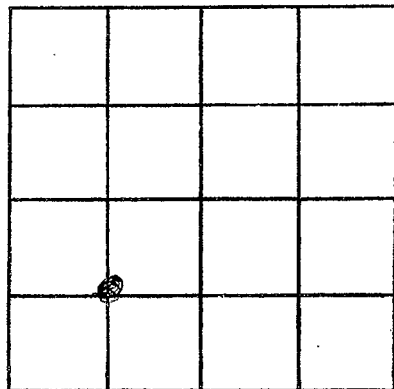

SECTION 4

Please indicate well location X.

ADDITIONAL INFORMATION

If more than one screen, show locations of each on sketch.