

LEFLORE

J 34

2-28-75

MISSISSIPPI  
 BOARD OF WATER COMMISSIONERS  
 416 North State Street  
 Jackson, Mississippi 39201

COMM

WATER WELL DRILLERS LOG

2-28-75  
date well completed

EUTANE GAS CO. OF GREENWOOD

Leflore

firm name

county well located


LANDOWNER:	description of formations encountered	from	to
E.K. Gilliland			
Itta Bena (mailing address)	Fine Sand	20	40
WELL LOCATION:	COARSE SAND	40	50
sec. <u>2</u> T. <u>19</u> N R. <u>2</u> W	Sand & GRAVEL	50	70
<u>3</u> miles <u>NW</u> of <u>Itta Bena</u>	GRAVEL	70	95
(distance) (direction) (nearest town)			
WELL PURPOSE: <u>FRR</u> (home, irrigation, municipal, industrial)			
WELL COMPLETION DATA:			
(1) diameter (inches) <u>16"</u>			
(2) total depth (feet) <u>70</u>			
(3) static water level (feet) <u>16</u> below top of ground.			
(4) casing <u>Steel</u> , <u>50</u> (material) (depth)			
<u>16"</u> If telescope see back. (size)			
(5) screen <u>40'</u> , <u>50</u> (length) (depth to top)			
<u>16"</u> , <u>Steel</u> (size) (material)			
(6) pump <u>50</u> , <u>2500</u> (HP) (yield gpm)			
<u>Diesel</u> (type power)			
(7) electric log <u>NO</u> (yes or no)			
(organization running log)			
(8) how well bottom plugged <u>Steel Plate</u>			
DRILLERS REMARKS:			

RECEIVED  
 MISSISSIPPI  
 MAR 24 1975

MISS. BD. OF WATER COMMISSIONERS

If well telescopes please sketch and show depths.

GROUND LEVEL

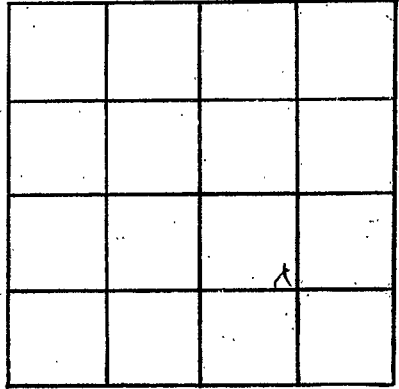

SECTION 2

Please indicate well location X.

ADDITIONAL INFORMATION

If more than one screen, show locations of each on sketch.