

Gw 3580

LEFLORE
J35
2-27-75

MISSISSIPPI
BOARD OF WATER COMMISSIONERS
416 North State Street
Jackson, Mississippi 39201

WATER WELL DRILLERS LOG

2/27/75 19 EUTANE GAS CO. OF GREENWOOD Leflore
date well completed firm name county well located

LANDOWNER:
MURPHEY BROS.
ITTA BENA
(mailing address)

| description of formations encountered | from | to |
|---------------------------------------|-----------|-----------|
| <u>CLAY</u> | <u>0</u> | <u>10</u> |
| <u>SANDY CLAY</u> | <u>10</u> | <u>20</u> |
| <u>SAND & PEA GRAVEL</u> | <u>20</u> | <u>50</u> |
| <u>SAND & GRAVEL</u> | <u>50</u> | <u>77</u> |

WELL LOCATION:
sec. 2² T 19 N R. 2 E
W
2 miles SW of ITTA BENA
(distance) (direction) (nearest town)

WELL PURPOSE: IRR
(home, irrigation, municipal, industrial)

- WELL COMPLETION DATA:
- (1) diameter (inches) 12"
 - (2) total depth (feet) 77
 - (3) static water level (feet) 16 below above top of ground.
 - (4) casing Steel 57
(material) (depth)
12" if telescope see back.
(size)
 - (5) screen 40' 57
(length) (depth to top)
12" Steel
(size) (material)
 - (6) pump 40 1800
(HP) (yield gpm)
Elec.
(type power)
 - (7) electric log No
(yes or no)
- (organization running log)
- (8) how well bottom plugged Steel plate


RECORDED
MAR 24 1975

DRILLERS REMARKS:

MISS. BD. OF WATER COM.

If well telescopes please sketch and show depths.

GROUND LEVEL

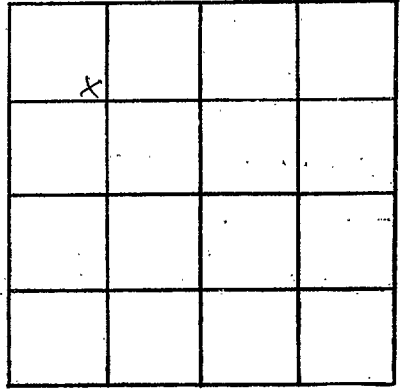

SECTION 23

Please indicate well location X.

ADDITIONAL INFORMATION

If more than one screen, show locations of each on sketch.