

MISSISSIPPI
BOARD OF WATER COMMISSIONERS
416 North State Street
Jackson, Mississippi 39201

CODED

WATER WELL DRILLERS LOG

LeFlore
T 36
3-67

3/17 1967 BUTANE GAS Co of GREENWOOD LEFLORE
date well completed firm name county well located

LANDOWNER:
JOHN BRATTON
LHA BENA
(mailing address)

WELL LOCATION:
sec. 17 T 19 N R 2 E
W
6 miles WEST of LHA BENA
(distance) (direction) (nearest town)

description of formations encountered	from	to
Top	0	30
FINE SAND	30	40
Coarse Sand & Gravel	40	100

WELL PURPOSE: IRRIGATION
(home, irrigation, municipal, industrial)

CODED

WELL COMPLETION DATA:

(1) diameter (inches) 12"

(2) total depth (feet) 98'

(3) static water level (feet) 17 below top of ground.

(4) casing Black, 58' (material) (depth)
12" (size) If telescope see back.


(5) screen 40', 58' (length) (depth to top)
12 (size), BLACK (material)

(6) pump 15 (HP) 1600 (yield gpm)
L.P. Gas (type power)

(7) electric log No (yes or no)
(organization running log)


(8) how well bottom plugged
STEEL PLATE

DRILLERS REMARKS:

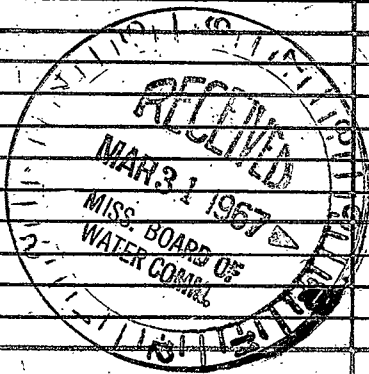

If well telescopes please sketch and show depths.

GROUND LEVEL

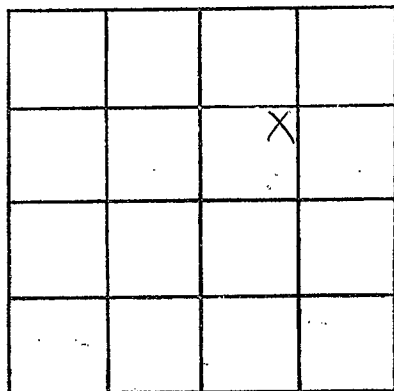

SECTION 17

Please indicate well location X.

ADDITIONAL INFORMATION

If more than one screen, show locations of each on sketch.