

MISSISSIPPI
BOARD OF WATER COMMISSIONERS
416 North State Street
Jackson, Mississippi 39201

CODED

WATER WELL DRILLERS LOG

Leflore
T 37
3-67

3/22/67 19 BUTANE GAS Co GREENWOOD LEFLORE
date well completed firm name county well located

LANDOWNER:
HARRY GLENN
ITTA BENA
(mailing address)

description of formations encountered	from	to
	<u>Top</u>	<u>0</u>
<u>FINE SAND</u>	<u>31</u>	<u>40</u>
<u>COARSE SAND & GRAVEL</u>	<u>40</u>	<u>100</u>


WELL LOCATION:
sec. 9 T 19 N R. 2 E
6 miles WEST of ITTA BENA
(distance) (direction) (nearest town)

CODED

WELL PURPOSE: IRRIGATION
(home, irrigation, municipal, industrial)

- WELL COMPLETION DATA:**
- (1) diameter (inches) 12"
 - (2) total depth (feet) 100'
 - (3) static water level (feet) 17' below above top of ground.
 - (4) casing Black, 60',
(material) (depth)
12" If telescope see back.
(size)
 - (5) screen 40', 60'
(length) (depth to top)
12", Black
(size) (material)
 - (6) pump 15HP 1200
(HP) (yield gpm)
LPG
(type power)
 - (7) electric log No
(yes or no)


(organization running log)
 - (8) how well bottom plugged
STEEL PLATE

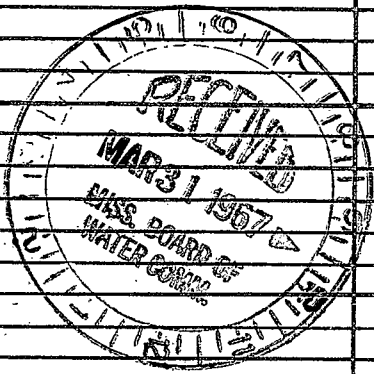

DRILLERS REMARKS:

If well telescopes please sketch and show depths.

GROUND LEVEL

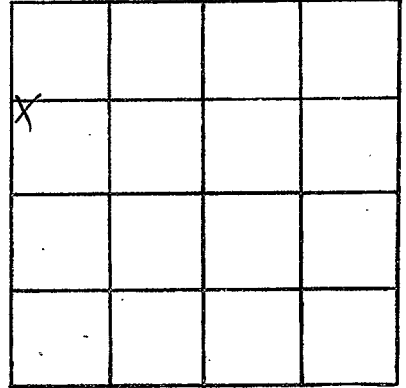

SECTION 9

Please indicate well location X.

ADDITIONAL INFORMATION

If more than one screen, show locations of each on sketch.