

*Leffure*  
 J 38  
 7-67

MISSISSIPPI  
 BOARD OF WATER COMMISSIONERS  
 416 North State Street  
 Jackson, Mississippi 39201

CODED

WATER WELL DRILLERS LOG

*Leffure*

July 10 '67 date well completed      19 Butane Gas of Greenwood Drm name      July 10 1967 county well located

LANDOWNER:

MURPHEY BROS.  
 PITA BEAN, Miss  
 (mailing address)

description of formations encountered

	from	to
Top Soil	0	25
Clay & Sand streaks	25	55
Coarse Sand & GRAVEL	55	110

WELL LOCATION:

sec 35 T 19 N R 2 E W  
 3 miles S&W of PITA BEAN  
 (distance) (direction) (nearest town)


CODED

WELL PURPOSE: *IRRIGATION*  
 (home, irrigation, municipal, industrial)

WELL COMPLETION DATA:


- (1) diameter (inches) 12"
- (2) total depth (feet) 110ft
- (3) static water level (feet) 15 below top of ground.
- (4) casing STEEL, 70',  
 (material) (depth)  
12" if telescope see back.  
 (size)
- (5) screen 40', 70'  
 (length) (depth to top)  
12", BLACK STEEL  
 (size) (material)
- (6) pump 50 1800  
 (HP) (yield gpm)  
TRACTOR LPG  
 (type power)
- (7) electric log NO  
 (yes or no)  
 (organization running log)
- (8) how well bottom plugged  
STEEL PLATE

DRILLERS REMARKS:

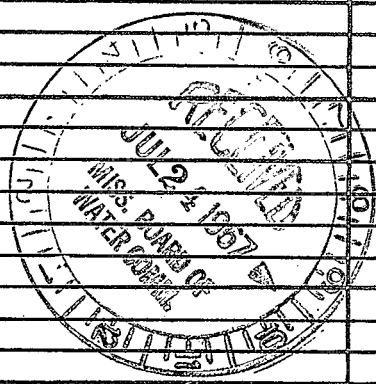

If well telescopes please sketch and show depths.

GROUND LEVEL

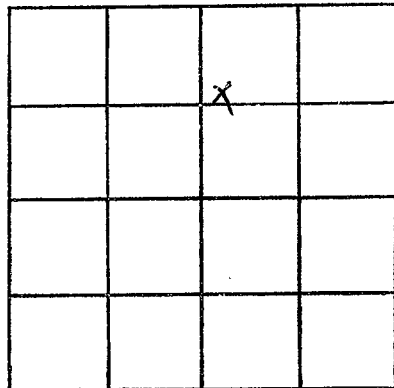

SECTION 35

Please indicate well location X.

ADDITIONAL INFORMATION

If more than one screen, show locations of each on sketch.