

**LEFLORE**  
**J 45**  
**4-8-77**

**MISSISSIPPI**  
**BOARD OF WATER COMMISSIONERS**  
 416 North State Street  
 Jackson, Mississippi 39201

**CODED**

**WATER WELL DRILLERS LOG**

4-8-77 19 BUTANE GAS CO. OF GREENWOOD Leflore  
 date well completed firm name county well located

**LANDOWNER:**  
DR. L.C. Wilson  
Kennett Mo.  
 (mailing address)

description of formations encountered	from	to
	Clay	0
SAND	30	60
SAND & GRAVEL	60	96

**WELL LOCATION:**  
 sec. 8 T. 19 N. R. 2 W.  
7 miles NW of ITHA BENA  
 (distance) (direction) (nearest town)

**WELL PURPOSE:** FRP  
 (home, irrigation, municipal, industrial)

**WELL COMPLETION DATA:**

(1) diameter (inches) 16

(2) total depth (feet) 96

(3) static water level (feet) 20 below above top of ground.

(4) casing Steel 56  
 (material) (depth)  
16" if telescope see back.  
 (size)

(5) screen 40 56  
 (length) (depth to top)  
16" Steel  
 (size) (material)

(6) pump 50 2500  
 (HP) (yield gpm)  
Diesel  
 (type power)

(7) electric log no  
 (yes or no)

(organization running log)

(8) how well bottom plugged Steel Plate

**CODED**


**RECEIVED**

APR 18 1977

**DRILLERS REMARKS:**

If well telescopes please sketch and show depths.

GROUND LEVEL

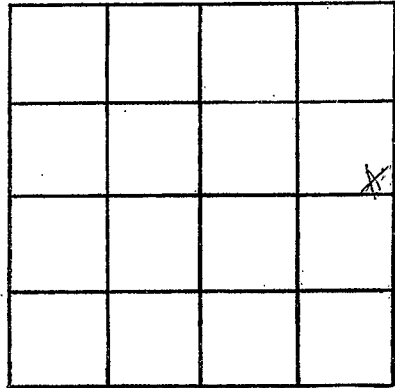

SECTION 8

Please indicate well location X.

ADDITIONAL INFORMATION

If more than one screen,  
show locations of each on sketch.