

LEFLORE

J 46

4-4-77

MISSISSIPPI BOARD OF WATER COMMISSIONERS  
416 North State Street  
Jackson, Mississippi 39201

WATER WELL DRILLERS LOG CODED

4-4-77

BUTANE GAS CO. OF GREENWOOD

Leflore

date well completed

firm name

county well located

LANDOWNER:

Simmons + Bell

Greve Land

(mailing address)

description of formations encountered

from

to

CLAY

0

40

SAND

40

60

SAND & GRAVEL

60

94

WELL LOCATION:

sec. 22 T 19 N R 2 W  
S P

2 1/2 miles NW of Ithaca Beach  
(distance) (direction) (nearest town)

WELL PURPOSE:

(home, irrigation, municipal, industrial)

IRR.

WELL COMPLETION DATA:

- (1) diameter (inches) 16
- (2) total depth (feet) 94
- (3) static water level (feet) 18 below above top of ground.
- (4) casing Steel 54 (material) (depth)  
16" (size) If telescope see back.
- (5) screen 40 54 (length) (depth to top)  
16" Steel (size) (material)
- (6) pump 60 3000 (HP) (yield gpm)  
Diesel (type power)
- (7) electric log NO (yes or no)

(organization running log)

(8) how well bottom plugged  
Steel Plate

DRILLERS REMARKS:

CODED


RECEIVED

APR 18 1977

MISS. BD. OF WATER COMMISSIONERS

If well telescopes please sketch and show depths.

GROUND LEVEL

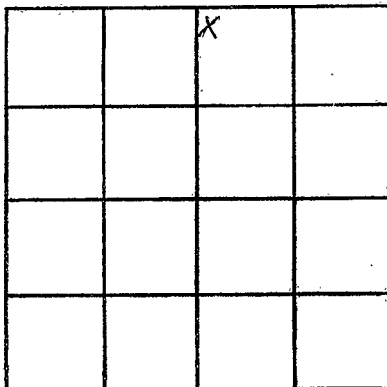

SECTION 22

Please indicate well location X.

ADDITIONAL INFORMATION

If more than one screen,  
show locations of each on sketch.