

LEFLORE
 J 47
 4/5/78

MISSISSIPPI
 BOARD OF WATER COMMISSIONERS
 416 North State Street
 Jackson, Mississippi 39201

WATER WELL DRILLERS LOG
 BUTANE GAS COMPANY

CODED

Leflore

4-5-78 19
 date well completed

OF GREENWOOD
 name

county well located

LANDOWNER:
 JOHN BRATTON
 ITTA BENA
 (mailing address)

description of formations encountered	from	to
CLAY	0	20
SAND	20	30
SAND + PEA GRAVEL	30	50
SAND + GRAVEL	50	90
ROCK	90	

WELL LOCATION:
 sec. 14 T. 19 N R. 2 E
 S W
 3 miles SW of ITTA BENA
 (distance) (direction) (nearest town)

WELL PURPOSE: FRR
 (home, irrigation, municipal, industrial)

WELL COMPLETION DATA:

(1) diameter (inches) 16"

(2) total depth (feet) 90

(3) static water level (feet) 20 below above top of ground.

(4) casing Steel 50 (material) (depth)
 16" (size) if telescope see back.

(5) screen 40 50 (length) (depth to top)
 16" (size) Steel (material)

(6) pump 60 3000 (HP) (yield gpm)
 Diesel (type power)

(7) electric log NO (yes or no)

(organization running log)

(8) how well bottom plugged Steel Plate

CODED


RECEIVED
 APR 24 1978

DRILLERS REMARKS:

MISS. BD. OF WATER COMMISSIONERS

If well telescopes please sketch and show depths.

GROUND LEVEL

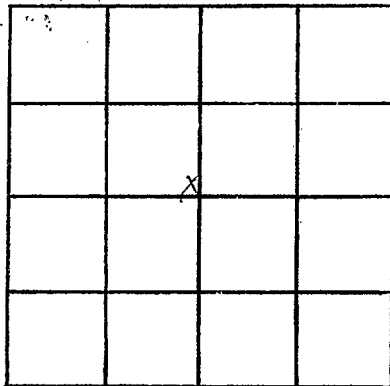

SECTION 14

Please indicate well location X.

ADDITIONAL INFORMATION

If more than one screen, show locations of each on sketch.