

LEFLORE
 J 48
 5-11-79

MISSISSIPPI
 BOARD OF WATER COMMISSIONERS
 416 North State Street
 Jackson, Mississippi 39201

CODED

WATER WELL DRILLERS LOG
 BUTANE GAS COMPANY

Leflore

5-11 1979
 date well completed

OF GREENWOOD

county well located

LANDOWNER:
 Simmons & Belk
 Cleveland
 (mailing address)

description of formations encountered	from	to
Clay	0	27
SAND	27	30
SAND + PEA GRAVEL	30	70
SAND & GRAVEL	70	96

WELL LOCATION:
 sec. 22 T 19 N R 2 E
 S W
 3 1/2 miles NW of Ithaca
 (distance) (direction) (nearest town)

WELL PURPOSE: F.P.R.
 (home, irrigation, municipal, industrial)

WELL COMPLETION DATA:
 (1) diameter (inches) 16"
 (2) total depth (feet) 96
 (3) static water level (feet) 20 below top of ground.
 (4) casing Steel 56 (material) (depth)
 16" (size) if telescope see back.
 (5) screen 40 56 (length) (depth to top)
 16" (size) Steel (material)
 (6) pump 60 3000 (HP) (yield gpm)
 Diesel (type power)
 (7) electric log N (yes or no)
 (organization running log)
 (8) how well bottom plugged Steel plate

DRILLERS REMARKS:


Miss. Board of Water Comm.

JUN - 8 1979

RECEIVED

If well telescopes please sketch and show depths.

GROUND LEVEL

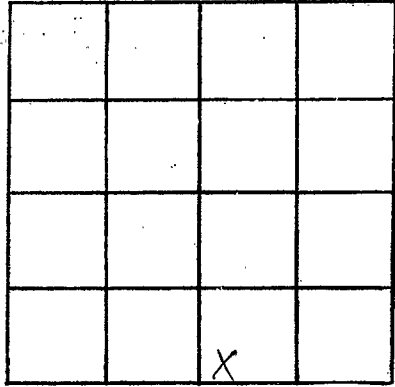

SECTION 22

Please indicate well location X.

ADDITIONAL INFORMATION

If more than one screen, show locations of each on sketch.