

LEFLORE  
J49  
4-18-79

MISSISSIPPI  
BOARD OF WATER COMMISSIONERS  
416 North State Street  
Jackson, Mississippi 39201

CODED

WATER WELL DRILLERS LOG

April 18, 1979 Bruce Berryman - Leflore  
date well completed firm name county well located  
Greenwood.

LANDOWNER: Manuel Gibson

Rt. 1. Box 42

Itta Bena, MS 38941  
(mailing address)

WELL LOCATION:

NE 1/4 sec 35 T 19 N R 2 W  
in town miles of Berclair  
(distance) (direction) (nearest town)

WELL PURPOSE: Home  
(home, irrigation, municipal, industrial)

WELL COMPLETION DATA:

(1) diameter (inches) 4" x 2"

(2) total depth (feet) 1084 ft.

(3) static water level (feet) Flow <sup>2513</sup> above top of ground.

(4) casing 4" Blk - 126 ft. 2" Galv - 938 ft.  
(material) (depth)

(size) If telescope see back.

(5) screen 20ft 1064'  
(length) (depth to top)

.010 Stainless steel  
(size) (material)

(6) pump 3/4 15  
(HP) (yield gpm)

Electric  
(type power)

(7) electric log No  
(yes or no)

(organization running log)

(8) how well bottom plugged B.P.V.

description of formations encountered

from


to

Clay	0	20
Sand	20	60
Sand & Gravel	60	140
Clay	140	200
Sand	200	300
Shale	300	360
Sand	360	400
Shale	400	560
Green sand	560	600
Shale	600	620
Sand	620	650
Shale	650	680
Sand	680	700
Shale	700	760
Sandy shale	760	800
Shale	800	850
Sand	850	860
Sandy shale	860	940
Sand	940	970
Shale	970	1050
Sand	1050	1090

DRILLERS REMARKS:

If well telescopes please sketch and show depths.

GROUND LEVEL

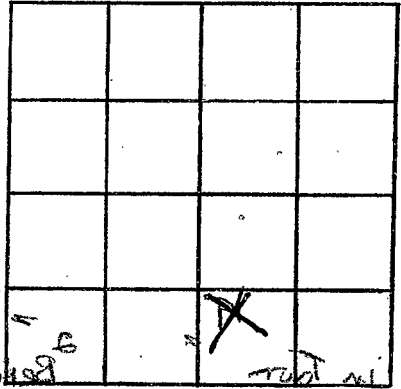

SECTION 3.5

Please indicate well location X.

ADDITIONAL INFORMATION

If more than one screen, show locations of each on sketch.