

LET 1056

J-50

11-13-80

11/13/80

MISSISSIPPI
 BOARD OF WATER COMMISSIONERS
 416 North State Street
 Jackson, Mississippi 39201

CODED

WATER WELL DRILLERS LOG
 BUTANE GAS COMPANY

LE FLORE

date well completed

OF GREENWALD

county well located

LANDOWNER: Bob Cooper
188 South McLEAN #11
Memphis TN 38104
 (mailing address)

description of formations encountered

from to

Clay	0	38
SAND	38	40
SAND & GRAVEL	40	104

WELL LOCATION:

sec. 32 T 19 N R 2 E
1 1/2 miles W of Colony
 (distance) (direction) (nearest town)

WELL PURPOSE: IRRIGATION
 (home, irrigation, municipal, industrial)

WELL COMPLETION DATA:

- (1) diameter (inches) 16"
- (2) total depth (feet) 104
- (3) static water level (feet) 20 below top of ground.
- (4) casing STEEL, 66'
 (material) (depth)
16" if telescope see back.
 (size)
- (5) screen 40', 66'
 (length) (depth to top)
16", STEEL
 (size) (material)
- (6) pump 60, 3500
 (HP) (yield gpm)
DIESEL
 (type power)
- (7) electric log No
 (yes or no)
No
 (organization running log)
- (8) how well bottom plugged:
STEEL PLATE


DEPT. OF NATURAL RESOURCES
 BUREAU OF LAND & WATER RESOURCES

DEC - 1 1980
 RECEIVED

DRILLERS REMARKS:

If well telescopes please sketch and show depths.

GROUND LEVEL

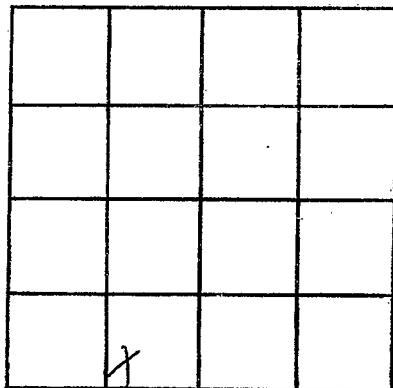

SECTION 32

Please indicate well location X.

ADDITIONAL INFORMATION

If more than one screen, show locations of each on sketch.