

LEFLORE  
J 51  
3/12/81

MISSISSIPPI  
 BOARD OF WATER COMMISSIONERS  
 416 North State Street  
 Jackson, Mississippi 39201

**CODED**

WATER WELL DRILLERS LOG  
 BUTANE GAS COMPANY  
 OF GREENWOOD

Leflore  
 county well located

3-12-81 19  
 date well completed

LANDOWNER:  
Derwood Strain  
MORGAN City  
 (mailing address)

description of fomations encountered	from	to
<u>Clay</u>	<u>0</u>	<u>38</u>
<u>SAND</u>	<u>38</u>	<u>40</u>
<u>SAND &amp; Pea GRAVEL</u>	<u>40</u>	<u>50</u>
<u>SAND &amp; GRAVEL</u>	<u>50</u>	<u>104</u>

WELL LOCATION:  
 sec. 1 T 19 N R. 2 E  
 S W  
3 1/2 miles NW of Etta Beva  
 (distance) (direction) (nearest town)

**CODED**

WELL PURPOSE: IR  
 (home, irrigation, municipal, industrial)

- WELL COMPLETION DATA:
- diameter (inches) 16"
  - total depth (feet) 104
  - static water level (feet) 20 below above top of ground.
  - casing Steel, 64,  
 (material) (depth)  
16" if telescope see back.  
 (size)
  - screen 40, 64  
 (length) (depth to top)  
16" Steel  
 (size) (material)
  - pump 50 2500  
 (HP) (yield gpm)  
Elec.  
 (type power)
  - electric log N  
 (yes or no)  
 (organization running log)
  - how well bottom plugged  
Steel Plate


DEPT. OF NATURAL RESOURCES  
 BUREAU OF LAND & WATER RESOURCES

MAR 19 1981  
**RECEIVED**

DRILLERS REMARKS:

If well telescopes please sketch and show depths.

GROUND LEVEL

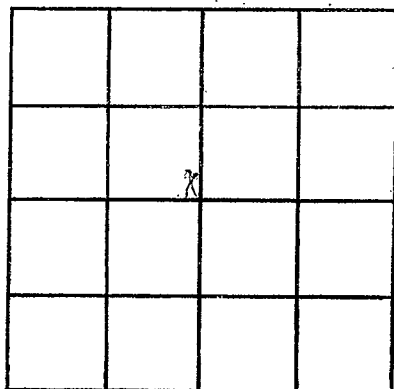

SECTION   1  

Please indicate well location X.

ADDITIONAL INFORMATION

If more than one screen, show locations of each on sketch.