

*Leflore*  
 J54  
 4-27-81

MISSISSIPPI DEPARTMENT OF NATURAL RESOURCES  
 Bureau of Land and Water Resources  
 Southport Mall  
 P.O. Box 10631  
 Jackson, Mississippi 39209  
**WATER WELL DRILLERS LOG**

Fig #2  
 Charles  
**CODED**

4-27 1981 DYER WELL & IRR. Leflore  
 date well completed firm name county well located


LANDOWNER: Ermy Andrus  
Itha Bene, Miss.  
 (mailing address)  
 WELL LOCATION:  
 sec. 21 T. R (N) S. R. 2 E  
4 miles North of Colony Plains  
 (distance) (direction) (nearest town)

description of formations encountered	from	to
Clay	13	23
Clay	23	33
Clay	33	43
Sand	43	53
Sand	53	63
Sand & Shavel	63	73
Sand & Shavel	73	83
Shavel	83	93
Shavel	93	103
ONA Rock	103	109

WELL PURPOSE: irrigation  
 (home, (irrigation), municipal, industrial)

WELL COMPLETION DATA:  
 (1) diameter (inches) 16"  
 (2) total depth (feet) 109'  
 (3) static water level (feet) 21' below above top of ground.  
 (4) casing Steel, 69'  
 (material), (depth)  
16" if telescope see back.  
 (size)  
 (5) screen 40', 69'  
 (length), (depth to top)  
16", Steel  
 (size), (material)  
 (6) pump 60 3000  
 (HP), (yield gpm)  
Diesel  
 (type power)  
 (7) electric log \_\_\_\_\_  
 (yes or no)  
 \_\_\_\_\_  
 (organization running log)  
 (8) how well bottom plugged plate


**CODED**

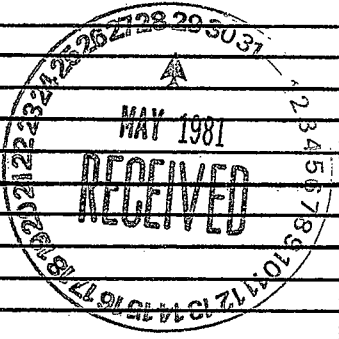

DRILLERS REMARKS:  
 \_\_\_\_\_  
 \_\_\_\_\_  
 \_\_\_\_\_

If well telescopes please sketch and show depths.

GROUND LEVEL

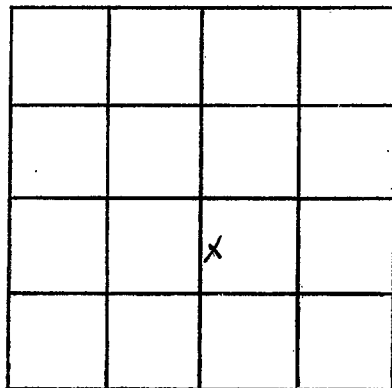

SECTION 21

Please indicate well location X.

ADDITIONAL INFORMATION

If more than one screen, show locations of each on sketch.