

Bureau of Land and Water Resources

Southport Mall

P.O. Box 10631

CODED

Jackson, Mississippi 39209

WATER WELL DRILLERS LOG

Leflore
555

5-22-81


Leflore


5-27-81

5-22-81 date well completed *Dyerswell & Irig* firm name Leflore county well located

LANDOWNER	Description of formations encountered	from	to
<i>Dyerswell & Irig</i>	Clay	0	30
<i>Bard, Mrs.</i> (mailing address)	<i>Silt Sand</i>	30	38
WELL LOCATION: sec. <i>12</i> T. <i>19</i> N. R. <i>2</i> E. S. <i>5</i>	<i>Sand</i>	38	55
7 miles <i>W W</i> of <i>ITTA BENA</i> (distance) (direction) (nearest town)	<i>Sand & Gravel</i>	55	103
WELL PURPOSE: (home, irrigation, municipal, industrial)			
WELL COMPLETION DATA: (1) diameter (inches) <i>12</i> (2) total depth (feet) (3) static water level (feet) <i>16</i> below top of ground. (4) casing <i>Steel</i> (material), (depth) <i>12</i> if telescope soo back. (size) (5) screen <i>40'</i> (length), (depth to top) <i>12</i> (size), (material) (6) pump <i>diesel</i> (HP), (yield gpm) (type power) (7) electric log (yes or no) (organ section running log) <i>Plate</i> (8) how well bottom plugged <i>Steel</i>			
DRILLERS REMARKS:			

CODED

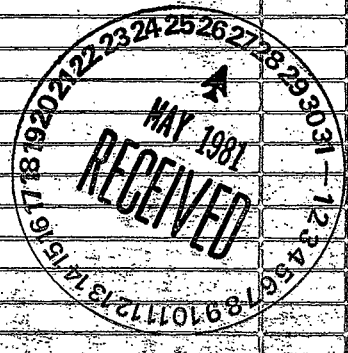

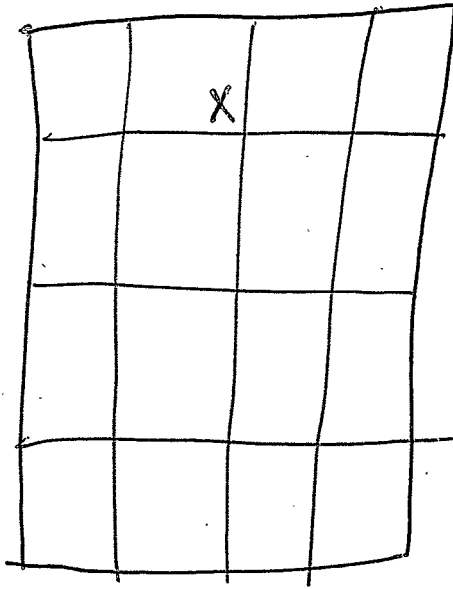

sec 17