

MISSISSIPPI DEPARTMENT OF NATURAL RESOURCES

Bureau of Land and Water Resources

Southport Mall

P.O. Box 10631

Jackson, Mississippi 39209

WATER WELL DRILLERS LOG

CODED

DeFlora
556
12-9-80

12-9 1980 DeFlora DeFlora
date well completed firm name county well located

LANDOWNER: Alan Mize

description of formations encountered from to

Rt. 1 Box 155

0-20' clay, topsoil
20-43 fine sand
43-93 sand gravel
93-103 sand

ITA Bena Miss.
(mailing address)


WELL LOCATION:
sec 1 T 19 N R 2 E
4 miles NW of ITA Bena
(distance) (direction) (nearest town)

WELL PURPOSE: Irrigation
(home, irrigation, municipal, industrial)

WELL COMPLETION DATA:

- (1) diameter (inches) 16"
- (2) total depth (feet) 103'
- (3) static water level (feet) 20' below top of ground.
- (4) casing Steel, 103'
(material) (depth)
- 16" If telescope see back.
(size)
- (5) screen 40', 63'
(length) (depth to top)
- 16" Steel
(size) (material)
- (6) pump 100 3000
(HP) (yield gpm)
- elective
(type power)
- (7) electric log _____
(yes or no)
- _____ (organization running log)
- (8) how well bottom plugged plugged

CODED

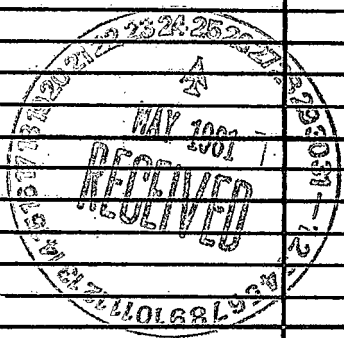

DRILLERS REMARKS:

If well telescopes please sketch and show depths.

GROUND LEVEL

		X	

SECTION 1

Please indicate well location X.

ADDITIONAL INFORMATION

If more than one screen,
show locations of each on sketch.