

MISSISSIPPI DEPARTMENT OF NATURAL RESOURCES
 Bureau of Land and Water Resources
 Southport Mall
 P.O. Box 10631
 Jackson, Mississippi 39205
WATER WELL DRILLERS LOG

CODED

De Lore
J 61
7/29/81

7/29/81 19 De Lore De Lore
 date well completed firm name county well located

LANDOWNER Merwood Strawn

description of formations encountered from to

2 Hts Bend, MS
 (mailing address)

Clay 13 23
Clay 23 33
Clay 33 43
Clay 43 53
san & gravel 53 63
san & gravel 63 73
gravel 73 83
san & gravel 83 93
Clay san & gravel 93 103

WELL LOCATION:
 sec. 9 T 19N R 2E
6 miles NW De Lore
 (distance) (direction) (nearest town)

WELL PURPOSE:
 (home, irrigation, municipal, industrial)


WELL COMPLETION DATA:

- (1) diameter (inches) 16
- (2) total depth (feet) 103'
- (3) static water level (feet) 20 below top of ground.
- (4) casing Steel 63'
 (material) (depth)
16 if telescope see back.
 (size)
- (5) screen 40' 63'
 (length) (depth to top)
16 Steel
 (size) (material)
- (6) pump 870 2000
 (HP) (yield gpm)
Electric
 (type power)
- (7) electric log NO
 (yes or no)

(organization running log)


(8) how well bottom plugged Plate

DRILLERS REMARKS:

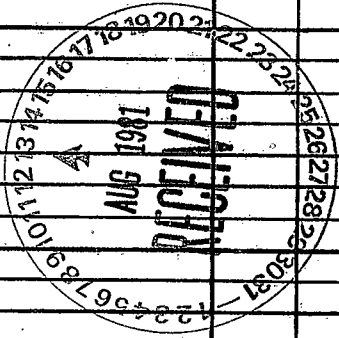

If well telescopes please sketch and show depths.

GROUND LEVEL

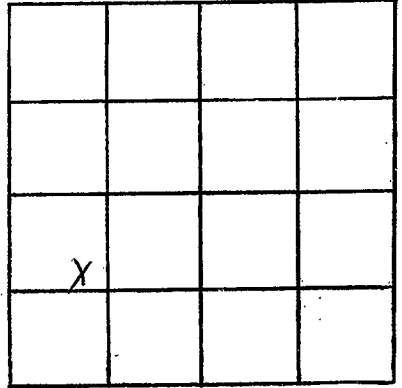

SECTION 9

Please indicate well location X.

ADDITIONAL INFORMATION

If more than one screen,
show locations of each on sketch.