

MISSISSIPPI DEPARTMENT OF NATURAL RESOURCES

Bureau of Land and Water Resources

Southport Mall

P.O. Box 10631

Jackson, Mississippi 39209

WATER WELL DRILLERS LOG

CODED

Leflore
J63
5-28-81

May 28 19 81 Lanny's well & pump Leflore
 date well completed farm name county well located

LANDOWNER:	description of formations encountered	from	to
George Rice			
Indianola MS (mailing address)	Clay	0	30
	Fine Sand	30	50
	Med. to Course	56	115
WELL LOCATION:			
sec. 12 T 19 N R 2 E			
3 miles NE of Itta Bena			
(distance) (direction) (nearest town)			
WELL PURPOSE:			
(home, irrigation, municipal, industrial)			
WELL COMPLETION DATA:			
(1) diameter (inches) 12"			
(2) total depth (feet) 115'			
(3) static water level (feet) 21' below top of ground.			
(4) casing Steel, 75' (material) (depth)			
(size) If telescope see back.			
(5) screen 40' 75' (length) (depth to top)			
12" Steel (size) (material)			
(6) pump 40 2000 (HP) (yield gpm)			
(type power)			
(7) electric log NO (yes or no)			
(organization running log)			
(8) how well bottom plugged Steel Plate			
DRILLERS REMARKS:			

CODED


DEPT. OF NATURAL RESOURCES
 BUREAU OF LAND & WATER RESOURCES

OCT 15 1981

RECEIVED

If well telescopes please sketch and show depths.

GROUND LEVEL

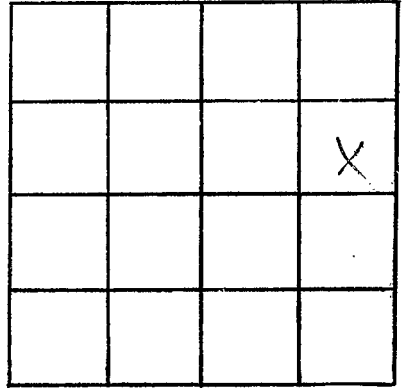

SECTION 12

Please indicate well location X.

ADDITIONAL INFORMATION

If more than one screen,
show locations of each on sketch.