

LEFLORE
J 66
3/83

MISSISSIPPI DEPARTMENT OF NATURAL RESOURCES
Bureau of Land and Water Resources
Southport Mall
P.O. Box 10631
Jackson, Mississippi 39209
WATER WELL DRILLERS LOG

CODED

date well completed 19 Dyer Well firm name Leflore county well located

LANDOWNER: <u>Triple "S"</u>	description of formations encountered	from	to
(mailing address)	<u>Clay</u>	<u>0</u>	<u>40</u>
WELL LOCATION: sec. <u>10-T-19N</u> R. <u>2-E</u> <u>4</u> miles <u>E</u> of <u>ITTA Bona</u> (distance) (direction) (nearest town)	<u>Thin sand</u>	<u>40</u>	<u>45</u>
WELL PURPOSE: (home, irrigation, municipal, industrial)	<u>Sand + gravel</u>	<u>40</u>	<u>103</u>
WELL COMPLETION DATA:	CODED		
(1) diameter (inches) <u>16</u>			
(2) total depth (feet) <u>103</u>			
(3) static water level (feet) <u>26</u> below above top of ground.			
(4) casing <u>PVC</u> <u>103</u> (material) (depth)			
_____ if telescope see back. (size)			
(5) screen <u>40'</u> (length) (depth to top)			
<u>16"</u> <u>PVC</u> (size) (material)			
(6) pump <u>50</u> <u>2500</u> (HP) (yield gpm)			
<u>electric</u> (type power)			
(7) electric log <u>no</u> (yes or no)			
_____ (organization running log)			
(8) how well bottom plugged <u>cap</u>			
DRILLERS REMARKS:			


DEPT. OF NATURAL RESOURCES
BUREAU OF LAND & WATER RESOURCES

MAY 9 - 1983

RECEIVED

If well telescopes please
sketch and show depths.

GROUND LEVEL

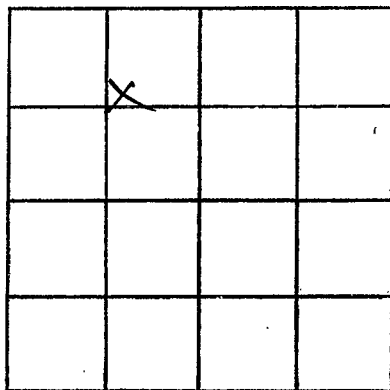

SECTION 10

Please indicate well location X.

ADDITIONAL INFORMATION

If more than one screen,
show locations of each on sketch.