

MISSISSIPPI DEPARTMENT OF NATURAL RESOURCES

Bureau of Land and Water Resources

Southport Mall

P.O. Box 10631

CODED

Jackson, Mississippi 39209

WATER WELL DRILLERS LOG  
BUTANE GAS CO. OF GREENWOOD

POST OFFICE BOX 1135

GREENWOOD, MISS. 38930 county well located

LEFLORE  
567  
5/6/83

5-6 1983  
date well completed

LANDOWNER:  
DAVID Brahan  
E Habens Mr.  
(mailing address)

description of formations encountered	from	to
Clay	0	20
Sand	20	60
Sand & gravel	60	110

WELL LOCATION:  
sec. 12 T-19 N R-2 E  
3.5 miles NW. of E Habens  
(distance) (direction) (nearest town)

WELL PURPOSE:  
(home, irrigation, municipal, industrial)

WELL COMPLETION DATA:

(1) diameter (inches) 16"

(2) total depth (feet) 110'

(3) static water level (feet) 32' below top of ground.

(4) casing Steel, 70' (material) (depth)  
16" (size) if telescope see back.

(5) screen 40', 70' (length) (depth to top)  
16", Steel (size) (material)

(6) pump 80 (HP) 1700 (yield gpm)  
Diem (type power)

(7) electric log No (yes or no)  
No (organization running log)

(8) how well bottom plugged No  
Steel plate

CODED

DEPT. OF NATURAL RESOURCES  
BUREAU OF LAND & WATER RESOURCES


JUN 10 1983

RECEIVED

DRILLERS REMARKS:  
Carlos Ramoa

If well telescopes please sketch and show depths.

GROUND LEVEL

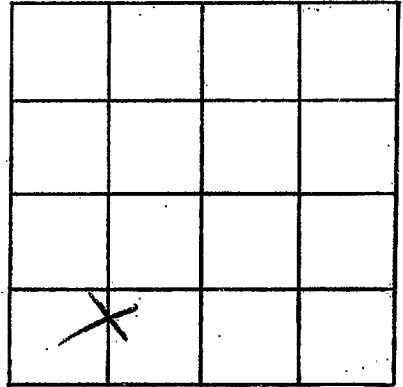

SECTION 12

Please indicate well location X.

ADDITIONAL INFORMATION

If more than one screen,  
show locations of each on sketch.