

MISSISSIPPI DEPARTMENT OF NATURAL RESOURCES

Bureau of Land and Water Resources

Southport Mall

P.O. Box 10631

CODED

Jackson, Mississippi 39209

WATER WELL DRILLERS LOG

BUTANE GAS CO. OF GREENWOOD

83 POST OFFICE BOX 1135

*Leflore*

LEFLORE  
J 68  
5/9/83

5-9  
date well completed

19

GREENWOOD, MISS: 38930

county well located

LANDOWNER:	description of formations encountered	from	to
<i>David Branham</i>			
<i>Ft Tabena, Mo</i> (mailing address)	<i>same</i>	<i>20</i>	<i>60</i>
	<i>same + gravel</i>	<i>60</i>	<i>110</i>
WELL LOCATION:			
sec. <i>12</i> T. <i>14</i> N. R. <i>2</i> E. <i>(W)</i>			
<i>3.5</i> miles <i>NW</i> of <i>Ettabena</i>			
(distance) (direction) (nearest town)			
WELL PURPOSE:			
(home, <u>irrigation</u> , municipal, industrial)			
WELL COMPLETION DATA:			
(1) diameter (inches) <i>16"</i>			
(2) total depth (feet) <i>96'</i>			
(3) static water level (feet) <i>30</i> <u>below</u> above top of ground.			
(4) casing <u>steel</u> , <u>56'</u> (material) (depth)			
<u>16"</u> if telescope see back. (size)			
(5) screen <u>40'</u> , <u>56'</u> (length) (depth to top)			
<u>16"</u> , <u>steel</u> (size) (material)			
(6) pump <u>80</u> , <u>1700</u> (HP) (yield gpm)			
<u>Deed</u> (type power)			
(7) electric log <u>No</u> (yes or no)			
<u>No</u> (organization running log)			
(8) how well bottom plugged <u>steel plate</u>			
DRILLERS REMARKS:			
<i>Carlos Ramos</i>			

CODED


DEPT. OF NATURAL RESOURCES  
BUREAU OF LAND & WATER RESOURCES

JUN 10 1983

RECEIVED

If well telescopes please sketch and show depths.

GROUND LEVEL

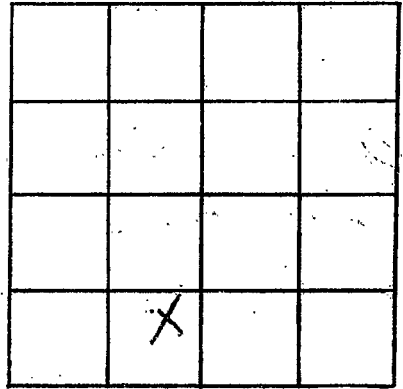

SECTION 12

Please indicate well location X.

ADDITIONAL INFORMATION

If more than one screen, show locations of each on sketch.