

MISSISSIPPI DEPARTMENT OF NATURAL RESOURCES

Bureau of Land and Water Resources

Southport Mall

P.O. Box 10631

Jackson, Mississippi 39209

WATER WELL DRILLERS LOG

BUTANE GAS COMPANY

OF GREENWOOD

LaFlore county well located

571
 LaFlore Co.
 45-84

CODED

4-5 1984
 date well completed

LANDOWNER:

description of formations encountered

from to

David Benham

CLAY

0 30

LaFlore (mailing address)

Fine sand

30 45

sand & gravel

45 110

WELL LOCATION:

sec. 14 T 19 N R 2 E S W
 4 miles (distance) near LaFlore (direction) of LaFlore (nearest town)

CODED

WELL PURPOSE:

(home, irrigation, municipal, industrial)

WELL COMPLETION DATA:

- (1) diameter (inches) 16"
- (2) total depth (feet) 110'
- (3) static water level (feet) 18 below top of ground.
- (4) casing steel 70' (material), (depth)
- 16" (size) if telescope see back.
- (5) screen 40' 70' (length), (depth to top)
- 16" (size), steel (material)
- (6) pump 60 (HP), 2500 (yield gpm)
- Electric (type power)
- (7) electric log No (yes or no)
- No (organization running log)

(8) how well bottom plugged steel plate

DRILLERS REMARKS:

Richard


DEPT. OF NATURAL RESOURCES
 BUREAU OF LAND & WATER RESOURCES

APR 23 1984

RECEIVED

If well telescopes please sketch and show depths.

GROUND LEVEL

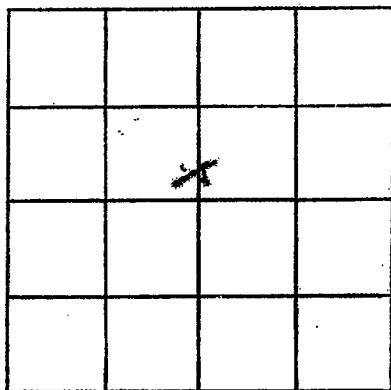

SECTION 14

Please indicate well location X.

ADDITIONAL INFORMATION

If more than one screen, show locations of each on sketch.