

MISSISSIPPI DEPARTMENT OF NATURAL RESOURCES

Bureau of Land and Water Resources

Southport Mall

P.O. Box 10631

Jackson, Mississippi 39209

WATER WELL DRILLERS LOG

J72
 Leflore Co.
 7-2-84

CODED

7-2-84

J & K Irrigation Well Leflore

date well completed

firm name

county well located

LANDOWNER:
 Jimmy Green
 (mailing address)

description of formations encountered	from	to
CLAY	0	32
2.0' FINE SAND	32	38
SAND GRAVEL	38	106

WELL LOCATION:
 sec. 5 T. 19 N. R. 2 E. S. 3 W.
 3 miles N. of Otter Beach
 (distance) (direction) (nearest town)

WELL PURPOSE:
 (home, irrigation, municipal, industrial)

WELL COMPLETION DATA:

(1) diameter (inches) 8

(2) total depth (feet) 106

(3) static water level (feet) 31' below top of ground.

(4) casing PVC 66 (material), (depth), 8 (size) if telescope see back.

(5) screen 40 66 (length), (depth to top), 8 (size), PVC (material)

(6) pump 15 (HP), 1000 (yield gpm), electric (type power)

(7) electric log no (yes or no)

(8) how well bottom plugged cap

CODED

MISSISSIPPI DEPARTMENT OF NATURAL RESOURCES
 BUREAU OF LAND & WATER RESOURCES


JUL 12 1984

RECEIVED

DRILLERS REMARKS:

If well telescopes please sketch and show depths.

GROUND LEVEL

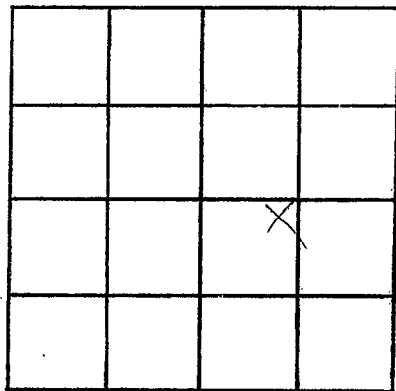

SECTION 5

Please indicate well location X.

ADDITIONAL INFORMATION

If more than one screen,
show locations of each on sketch.