

MISSISSIPPI DEPARTMENT OF NATURAL RESOURCES

Bureau of Land and Water Resources

Southport Mall

P.O. Box 10631

Jackson, Mississippi 39209  
WATER WELL DRILLERS LOG

CODED

LEFLORE  
J 94

12-15 1986  
date well completed

J & K Irrigation  
firm name

LeFlore  
county well located

LANDOWNER: Steve Scott  
611 Highway 80 Bypass  
Greenwood, Miss. 38930  
(mailing address)

WELL LOCATION:  
sec. 9 T. 19 N R. 2 W  
5 miles WEST of ITTI BEND  
(distance) (direction) (nearest town)

WELL PURPOSE: SHALIMP  
(home, irrigation, municipal, industrial)

- WELL COMPLETION DATA:
- (1) diameter (inches) 4"
  - (2) total depth (feet) 1387
  - (3) static water level (feet) 1 below top of ground.
  - (4) casing Steel 1327 (material) (depth)  
4 if telescope see back. (size)
  - (5) screen 60' 1327 (length) (depth to top)  
4 STAINLESS (size) (material)
  - (6) pump 7 1/2 175 (HP) (yield gpm)  
Electric (type power)
  - (7) electric log yes (yes or no)  
Miss. (organization running log)
  - (8) how well bottom plugged BACKWASH

description of formations encountered	from to	
TOP SOIL	0	12
CLAY	12	27
SAND	27	53
SAND & GRAVEL	53	138
CLAY	138	146
SAND	146	263
CLAY	263	276
SAND	276	587
ROCK	587	601
CLAY	601	650
SAND	650	682
Shale & Rock	682	873
SAND	873	921
Shale	921	1019
SAND	1019	1034
Shale	1034	1132
SAND	1132	1212
SANDY CLAY	1317	1389
Clay	1389	

CODED


RECEIVED  
DEC 15 1986

Department of Natural Resources  
Bureau of Land & Water Resources

DRILLERS REMARKS:

If well telescopes please  
sketch and show depths.

GROUND LEVEL

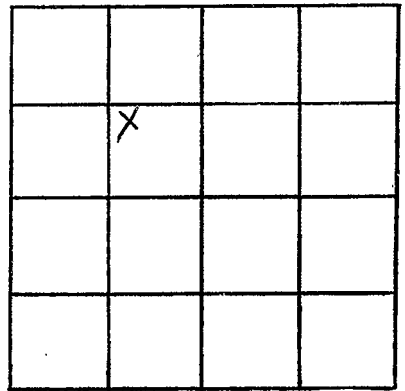

SECTION \_\_\_\_\_

Please indicate well location X.

ADDITIONAL INFORMATION

If more than one screen,  
show locations of each on sketch.