

MISSISSIPPI DEPARTMENT OF NATURAL RESOURCES

Bureau of Land and Water Resources

Southport Mall

P.O. Box 10631

Jackson, Mississippi 39209

WATER WELL DRILLERS LOG

Permit Applied For F-75 6-2

88 Dyer Well

Leflore

date well completed

firm name

county well located

LANDOWNER: Dr. Bob J. Herrin

304 University Suite 201
Marshall Tx 75670

(mailing address)

WELL LOCATION:

sec 21 T 19 N R 2 E
3 miles NW of Habemus
(distance) (direction) (nearest town)

WELL PURPOSE: Irrigation
(home, irrigation, municipal, industrial)

WELL COMPLETION DATA:

- (1) diameter (inches) 16"
- (2) total depth (feet) 107'
- (3) static water level (feet) _____ below/above top of ground.
- (4) casing steel (material), _____ (depth), 16" (size) if telescope see back.
- (5) screen 40' (length), _____ (depth to top), 16" (size) (material)
- (6) pump 60 (HP), _____ (yield gpm), Gear (type power)
- (7) electric log No (yes or no), None (organization running log)
- (8) how well bottom plugged Plate.

description of formations encountered

from

to

Clay	0	30
Fine Sand	30	40
Sand & Gravel	40	45
M Sand & Gravel	45	50
Fine Sand	50	65
M Sand & Gravel	65	70
Sand & Gravel	70	90
Fine Sand	90	107

RECEIVED


JUN 06 1988

Department of Natural Resources
Bureau of Land & Water Resources

DRILLERS REMARKS:

If well telescopes please sketch and show depths.

GROUND LEVEL

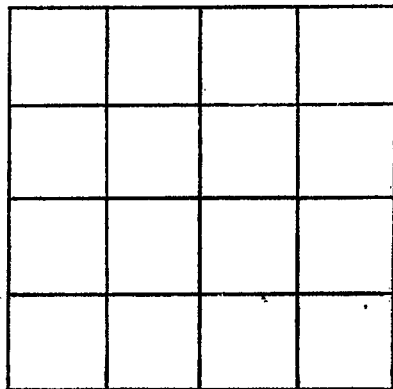

SECTION _____

Please indicate well location X.

ADDITIONAL INFORMATION

If more than one screen,
show locations of each on sketch.