

LEFLORE

J 80

10-22-68

MISSISSIPPI  
 BOARD OF WATER COMMISSIONERS  
 416 North State Street  
 Jackson, Mississippi 39201

CODED

WATER WELL DRILLERS LOG

10-22

19

68 DYER WELLS TRR.

LEFLORE

CODED

date well completed

firm name

county well located

LANDOWNER:

W. A. MOONEYHAM

ITTA BENA, Miss.  
(mailing address)

description of formations encountered

from

to

CLAY

0 21

SAND

21 96

SAND & GRA.

96 132

CLAY

132 182

SAND CLAY

182 218

SAND

218 476

SANDY SHALE

476 565

SANDY SHALE

565 592

ROCK

592 594

SANDY SHALE

594 702

SHALE & ROCK ST.

702 725

ROCK

725 726

SAND

726 741

ROCK STREAKS

741 804

SANDY SHALE

804 881

ROCK

881 882

SANDY SHALE

882 928

SAND

928 966

SANDY SHALE

966 980

WELL LOCATION:

sec. 35 T 19 N R 2 E  
 2 miles N.E. of BERCLAIR  
 (distance) (direction) (nearest town)

WELL PURPOSE: DOMESTIC (home, irrigation, municipal, industrial)

WELL COMPLETION DATA:

- (1) diameter (inches) 2"
- (2) total depth (feet) 965'
- (3) static water level (feet) Flow below above top of ground.
- (4) casing 2" BAW PIPE 945'  
(material) (depth)
- 2" if telescope see back.  
(size)
- (5) screen 20' 945'  
(length) (depth to top)
- 2" STAINLESS STEEL  
(size) (material)
- (6) pump 1 Flow  
(HP) (yield gpm)
- ELEC.  
(type power)
- (7) electric log NO  
(yes or no)

(organization running log)

(8) how well bottom plugged BAW  
VALVE

DRILLERS REMARKS:


FEB 17 1969

MISS. BD. OF  
WATER COMM.

If well telescopes please sketch and show depths.

GROUND LEVEL

*Connected with  
sledge rope.  
no lap pipe*

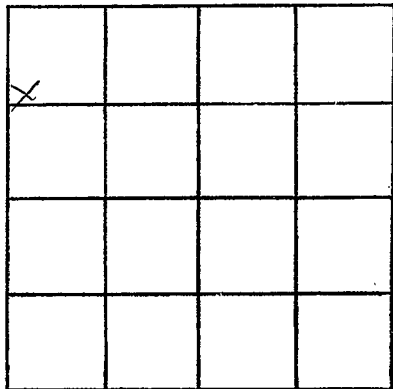

SECTION 31

Please indicate well location X.

ADDITIONAL INFORMATION

If more than one screen,  
show locations of each on sketch.