

MISSISSIPPI
BOARD OF WATER COMMISSIONERS
416 North State Street
Jackson, Mississippi 39201

WATER WELL DRILLERS LOG

BUTANE GAS CO. OF GREENWOOD

GREENWOOD, MISSISSIPPI

Leflore
J81
5-10-69

5/10/69 19
date well completed

firm name

Leflore
county well located

LANDOWNER:

R. L. Cooper
6 McLean
Memphis, Tenn.
(mailing address)

description of formations
encountered

Clay
SAND
SAND & GRAVEL

from

to

0 30
30 45
45 103

WELL LOCATION:

sec. 32 T. 19 N R. 2 E
6 miles W of Itta Bena
(distance) (direction) (nearest town)

WELL PURPOSE: IRRIGATION
(home, irrigation, municipal, industrial)

WELL COMPLETION DATA:

- (1) diameter (inches) 16"
- (2) total depth (feet) 103'
- (3) static water level (feet) 17' below top of ground.
- (4) casing Steel, 63' (depth)
16" (size) if telescope see back.
- (5) screen 40' (length), 63' (depth to top)
16" (size), Steel (material)
- (6) pump 60 (HP), 3000 (yield gpm)
NAT. GAS ENGINE (type power)
- (7) electric log NO (yes or no)

(organization running log)

(8) how well bottom plugged
Steel Plate

DRILLERS REMARKS:


CR

JUN 4 - 1969

MISS. BD. OF
WATER COM.

If well telescopes please sketch and show depths.

GROUND LEVEL

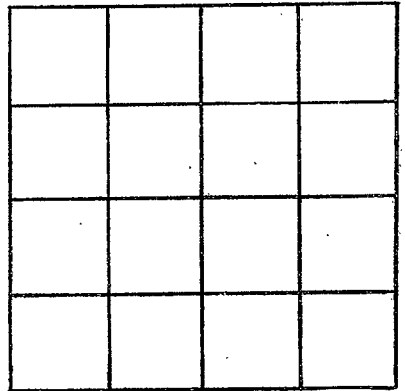

SECTION 32

Please indicate well location X.

ADDITIONAL INFORMATION

If more than one screen,
show locations of each on sketch.