

J-83
LEFLORE
9-5-80

MISSISSIPPI
BOARD OF WATER COMMISSIONERS
416 North State Street
Jackson, Mississippi 39201

WATER WELL DRILLERS LOG

BUTANE GAS COMPANY

SEPT 5 1980
date well completed

OF GREENWOOD

LEFLORE
county well located

LANDOWNER: <u>TIP TOP FARMS</u>	description of formations encountered	from	to
<u>Rt 1 Box 195</u>			
<u>SCHWARTZ, MS 38952</u>	<u>Clay</u>	<u>0</u>	<u>31</u>
(mailing address)	<u>SAND</u>	<u>31</u>	<u>43</u>
	<u>SAND & GRAVEL</u>	<u>43</u>	<u>103</u>

WELL LOCATION:
sec. L T 19 N R 2 E
S 4 W 4
4 miles NW of THA BENA
(distance) (direction) (nearest town)

CODED

WELL PURPOSE: IRRIGATION
(home, irrigation, municipal, industrial)

WELL COMPLETION DATA:

- (1) diameter (inches) 16"
- (2) total depth (feet) 103'
- (3) static water level (feet) 20 below above top of ground.
- (4) casing STEEL 63'
(material) (depth)
- (size) if telescope see back.
- (5) screen 40' 63'
(length) (depth to top)
- 16" STEEL
(size) (material)
- (6) pump 60 2500
(HP) (yield gpm)
- DIESEL
(type power)
- (7) electric log No
(yes or no)
- No
(organization running log)
- (8) how well bottom plugged
STEEL PLATE

DEPT OF NATURAL RESOURCES
BUREAU OF LAND & WATER RESOURCES


SEP 10 1980

RECEIVED

DRILLERS REMARKS:

If well telescopes please sketch and show depths.

GROUND LEVEL

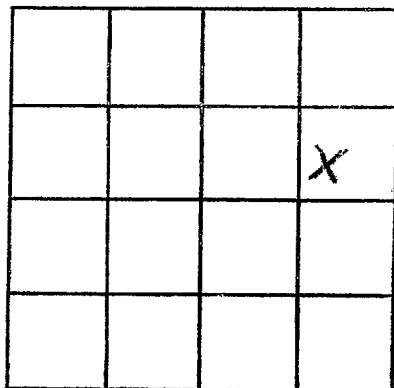

SECTION 1

Please indicate well location X.

ADDITIONAL INFORMATION

If more than one screen,
show locations of each on sketch.