

MISSISSIPPI DEPARTMENT OF NATURAL RESOURCES

Bureau of Land and Water Resources

Southport Mall

P.O. Box 10631

Jackson, Mississippi 39209

WATER WELL DRILLERS LOG

CODED

August 19, 1983 Dyer Well + Irr. Leflore  
 date well completed firm name county well located

LANDOWNER: Charles Kinble

description of formations encountered from to

254 7561

IHA Bena, Miss.  
 (mailing address)

Clay	0	24
Fine Sand	24	54
Sand + Gravel	54	110

WELL LOCATION:

sec. 23 T. 19(N) R. 2 E  
 S W  
 3 miles W of IHA Bena, Ms.  
 (distance) (direction) (nearest town)

WELL PURPOSE: Irrigation  
 (home, irrigation, municipal, industrial)

WELL COMPLETION DATA:

CODED

- (1) diameter (inches) 16
- (2) total depth (feet) 110'
- (3) static water level (feet) 22' below top of ground.
- (4) casing Steel, 70' (depth)  
 16 (size) If telescope see back.
- (5) screen 40' (length), 70' (depth to top)  
 16 (size) (material)
- (6) pump 40 (HP), 2,000 (yield gpm)  
 Propane (type power)
- (7) electric log No (yes or no)

(organization running log)

(8) how well bottom plugged Plate

DEPT. OF NATURAL RESOURCES  
 BUREAU OF LAND & WATER RESOURCES


DEC - 7 1983

DRILLERS REMARKS:

RECEIVED

If well telescopes please sketch and show depths.

GROUND LEVEL

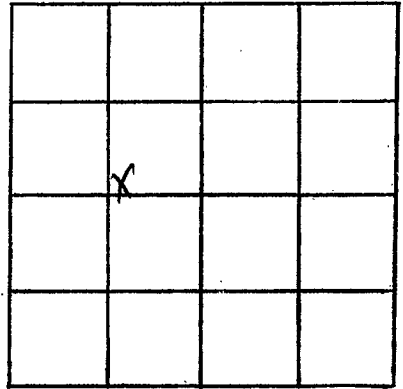

SECTION 23

Please indicate well location X.

ADDITIONAL INFORMATION

If more than one screen, show locations of each on sketch.