

MISSISSIPPI DEPARTMENT OF NATURAL RESOURCES

Bureau of Land and Water Resources

Southport Mall

P.O. Box 10631

Jackson, Mississippi 39209

WATER WELL DRILLERS LOG

CODED

LEFLORE
588
12/1/83

date well completed 19

Ayer well + Dring

firm name

Leflore

county well located

LANDOWNER: David Branch

description of formations encountered

from

to

JTA Bena, Miss.
(mailing address)

Clay	0	40
Sand	40	78
Sand + Gravel	78	103

WELL LOCATION:

sec. 13 T 19 R 2 S 1 W 1
3 miles North of JTA Bena
(distance) (direction) (nearest town)

WELL PURPOSE: Irrigation
(home, irrigation, municipal, industrial)

CODED

WELL COMPLETION DATA:

- (1) diameter (inches) 16"
- (2) total depth (feet) 103'
- (3) static water level (feet) 23' below top of ground.
- (4) casing Steel, 63' (material), (depth)
16" (size) if telescope see back.
- (5) screen 40' (length), 63' (depth to top)
16" (size), Mild Steel (material)
- (6) pump 80 (HP), 1700 (yield gpm)
Diesel (type power)
- (7) electric log No (yes or no)

(organization running log)

(8) how well bottom plugged Plate

DEPT. OF NATURAL RESOURCES
BUREAU OF LAND & WATER RESOURCES


DEC - 7 1983

DRILLERS REMARKS:

RECEIVED

If well telescopes please sketch and show depths.

GROUND LEVEL

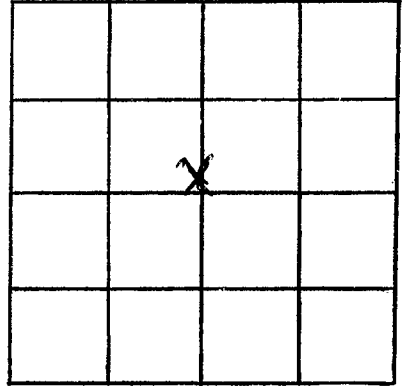

SECTION 13

Please indicate well location X.

ADDITIONAL INFORMATION

If more than one screen,
show locations of each on sketch.