

MISSISSIPPI DEPARTMENT OF NATURAL RESOURCES

Bureau of Land and Water Resources

Southport Mall

P.O. Box 10631

Jackson, Mississippi 39209

WATER WELL DRILLERS LOG

CODED

Leflore
J 89
7/19/84

19 84 BUTANE GAS COMPANY
OF GREENWOOD

Leflore
county well located

7-19
date well completed

LANDOWNER:	description of formations encountered	from	to
<u>D. H. Strain</u>	<u>Clay</u>	<u>0</u>	<u>18</u>
(mailing address)	<u>FINE SAND</u>	<u>18</u>	<u>55</u>
WELL LOCATION: sec. <u>34</u> T. <u>19</u> N. R. <u>2</u> E. <u>S</u> <u>W</u>	<u>SAND + pea gravel</u>	<u>55</u>	<u>80</u>
<u>6.25</u> miles <u>NW.</u> of <u>Itabena</u> (distance) (direction) (nearest town)	<u>gravel</u>	<u>80</u>	<u>103</u>
WELL PURPOSE: (home, <u>Irrigation</u> , municipal, industrial)	CODED		
WELL COMPLETION DATA: (1) diameter (inches) <u>16"</u>			
(2) total depth (feet) <u>103</u>			
(3) static water level (feet) <u>38</u> below above top of ground.			
(4) casing <u>Steel</u> , <u>63'</u> (material) (depth)			
<u>16"</u> if telescope see back. (size)			
(5) screen <u>40'</u> , <u>63'</u> (length) (depth to top)			
<u>16"</u> , <u>Steel</u> (size) (material)			
(6) pump <u>60</u> , <u>1100</u> (HP) (yield gpm)			
<u>Diesel</u> (type power)			
(7) electric log <u>No</u> (yes or no)			
<u>No</u> (organization running log)			
(8) how well bottom plugged: <u>Steel plate</u>			
DRILLERS REMARKS: <u>Richard Vest</u>			


DEPT. OF NATURAL RESOURCES
BUREAU OF LAND & WATER RESOURCES

AUG 6 1984

RECEIVED

If well telescopes please sketch and show depths.

GROUND LEVEL

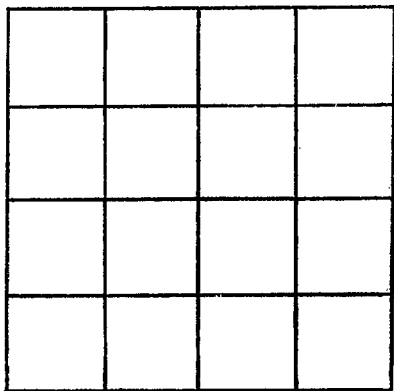

SECTION _____

Please indicate well location X.

ADDITIONAL INFORMATION

If more than one screen,
show locations of each on sketch.