

MISSISSIPPI DEPARTMENT OF NATURAL RESOURCES

Bureau of Land and Water Resources

Southport Mall

P.O. Box 10631

Jackson, Mississippi 39209

CODED

WATER WELL DRILLERS LOG  
BUTANE GAS COMPANY

OF GREENWOOD

Leflore  
J 90  
7/16/84

Leflore

7-15 1984  
date well completed

firm name

county well located

LANDOWNER:  
D. H. Strain  
Schlater Mr.  
(mailing address)

description of formations encountered

from to

<u>Clay</u>	<u>0</u>	<u>22</u>
<u>FINE SAND</u>	<u>22</u>	<u>46</u>
<u>SAND per gravel</u>	<u>46</u>	<u>60</u>
<u>gravel</u>	<u>60</u>	<u>93</u>
<u>Rock</u>	<u>93</u>	

WELL LOCATION:

sec. 34 T. 19 N. R. 2 E.  
6 miles N.W. of Ittabena  
(distance) (direction) (nearest town)

WELL PURPOSE:  
(home, irrigation, municipal, industrial)

WELL COMPLETION DATA:

- (1) diameter (inches) 16"
- (2) total depth (feet) 93
- (3) static water level (feet) 30 below top of ground.
- (4) casing steel, 53 (material) (depth)  
16" if telescope see back. (size)
- (5) screen 40', 53 (length) (depth to top)  
16", Steel (size) (material)
- (6) pump 60, 1100 (HP) (yield gpm)  
Diesel (type power)
- (7) electric log No (yes or no)  
No (organization running log)
- (8) how well bottom plugged Steel plate

CODED

DEPT. OF NATURAL RESOURCES  
BUREAU OF LAND & WATER RESOURCES

AUG 6 1984


RECEIVED

DRILLERS REMARKS:

Richard Vest

If well telescopes please sketch and show depths.

GROUND LEVEL

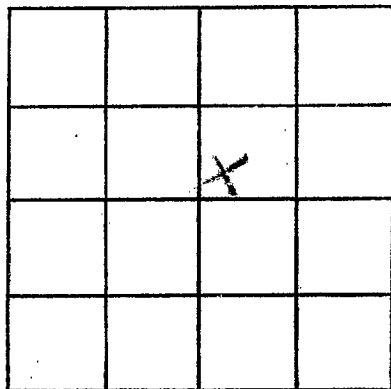

SECTION 3

Please indicate well location X.

ADDITIONAL INFORMATION

If more than one screen,  
show locations of each on sketch.