

LEFLORE
J. 91

MISSISSIPPI DEPARTMENT OF NATURAL RESOURCES

Bureau of Land and Water Resources

Southport Mall

P.O. Box 10631

Jackson, Mississippi 39209

WATER WELL DRILLERS LOG

CODED

9-24
date well completed


1984 J + K Irrigation ^{well}
firm name

Leflore
county well located

LANDOWNER:	description of formations encountered	from	to
Doug Clark Rulerille, Miss. (mailing address)	CLAY	0	14
WELL LOCATION: sec. 18 T. 10 N. R. 2 E 1 1/2 miles W of Itta Bena (distance) (direction) (nearest town)	SAND LIME	14	38
WELL PURPOSE: (home, irrigation, municipal, industrial)	SAND Gravel	38	103
WELL COMPLETION DATA: (1) diameter (inches) 8 (2) total depth (feet) 103 (3) static water level (feet) 31 below above top of ground. (4) casing PVC, 63 (material) (depth) 8 (size) if telescope see back. (5) screen 40 (length) (depth to top) 8 (size) PVC (material) (6) pump 10 (HP) 600 (yield gpm) electric (type power) (7) electric log NO (yes or no) (organization running log) (8) how well bottom plugged Cap	CODED		
DRILLERS REMARKS:	DEPT. OF NATURAL RESOURCES BUREAU OF LAND & WATER RESOURCES OCT 16 1984 RECEIVED		

If well telescopes please sketch and show depths.

GROUND LEVEL

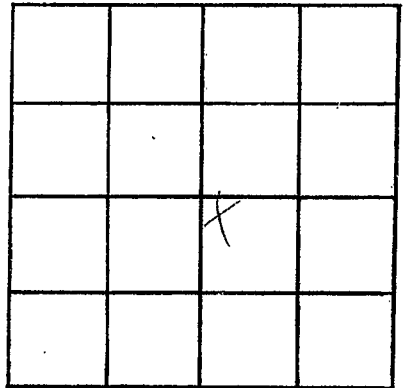

SECTION 18

Please indicate well location X.

ADDITIONAL INFORMATION

If more than one screen,
show locations of each on sketch.